IREDELL COUNTY HEALTH DEPARTMENT

STATESVILLE 704-878-5305 MOORESVILLE 704-664-5201

IMPROVEMENT PERMIT / AUTHORIZATION TO CONSTRUCT / OPERATION PERMIT / EXISTING SYSTEM INSPECTION

PERMIT# 07197 PIN# 4625941684 4635 04 9476 DATE July 25, '98

OWNER OR CONTRACTOR Crescent Resources Inc. PHONE: Business _____ Home _____

ADDRESS PO Box 1003, Charlotte

LOCATION Brawley Sch Rd TR The Pointe DR. Queen Anne Circle to Easton DR. on Right at jct w/ old Post Rd.

SUBDIVISION The Pointe BLOCK / SECTION 1A LOT 10 LOT AREA 33,896 ft² SITE CLASS. PS DESIGN FLOW 400 gpd L.T.A.R. .3

Septic Tank: 1500 Gallons; STB 797 Date 8/21/99

Pump Tank: 1000 Gallons; PT 27 Date 9/27/99

Pump Make: _____ Model _____ Serial No. _____

Nitrification Field: No Fields 1 Square Feet 1200 Linear Feet 400

No Lines 4@100' Trench Width 36" Max Trench Bottom Depth 36" Gravel Depth N/A

☑ New System ☐ Repair System Type: I, II, III, IV, V, VI

System Description: pumped-pm - 25% Reduction.

Repair System Description: LP 25-50% Reduction

Maintenance Agreement Required: ☐ Yes ☑ No initially

☑ House/Mod. Home ☐ Mobile Home ☐ Business ☐ Other

No. Bedrooms 4 No. Bathrooms 4 No. Employees _____

☐ Slab ☑ Crawl Space ☐ Basement w/plumbing ☐ Basement wo/plumbing


Water Supply: ☐ Individual ☐ Public ☑ Community

Comments:/Conditions: * ONE Inspection/Observation port per Lateral
Remove old Burms/Terraces.
Septic System installer to follow material specifications in The Pointe Wastewater Disposal Manual.

Comments:/Conditions:
4-30-99 Reviewed Issue site plan - appears in Compliance w/ I.P.
Tanks & lines Checked 11/1/99

INITIAL SITE SKETCH

1"=50'

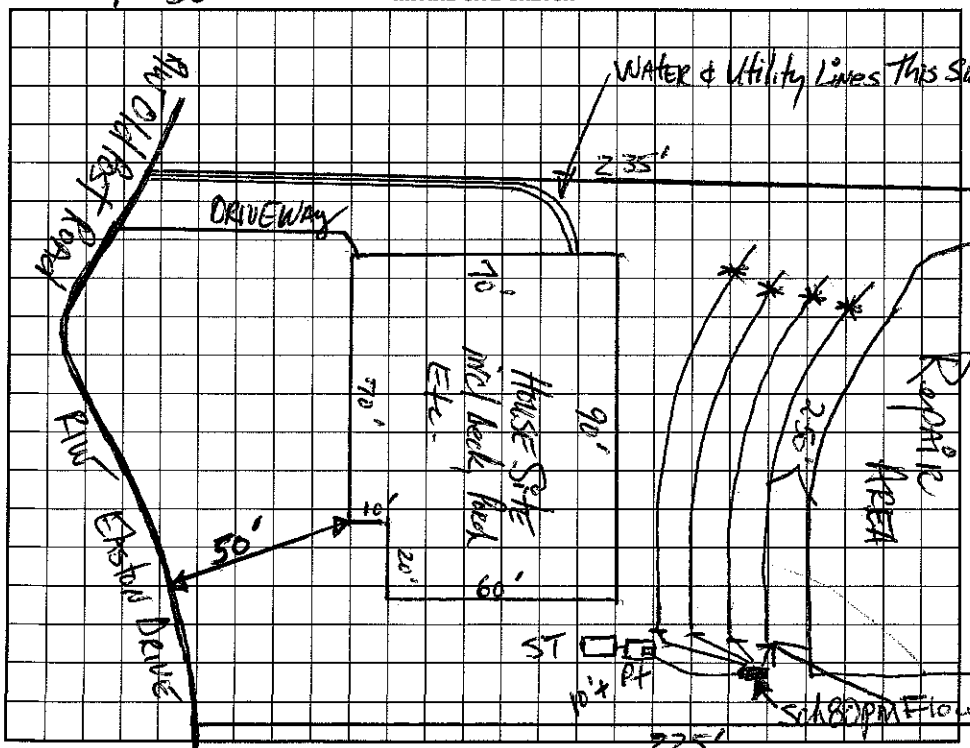

AS BUILT SKETCH

Installed as Drawn
Except 3-100' last line
Flow divider - to 2-50' lines

Recheck Alarm when power turned ON.

I understand that this permit can be suspended or revoked if any false information is supplied toward securing the permit/any unauthorized changes are made to the site/any unauthorized changes are made in the installation of the system. Improvement Permit with plat valid without expiration. Improvement Permit with site plan valid for sixty months. Authorization to Construct is valid for a period equal to that of Improvement Permit – not to exceed sixty months.

Signed: _____ date 8-2-98 Installed by: Mayhew Septic R.S.

Improvement Permit by: _____ date 7-25-98 Operation Permit by: _____ date 12/14/99

Authorization to Construct by: _____ date 4-30-99 Existing System Inspection by: _____ date _____

HEALTH DEPT. COPY: WHITE INSPECTION COPY (FINAL): GREEN OWNER COPY (FINAL): YELLOW INSPECTION COPY (INITIAL): PINK OWNER COPY (INITIAL): GOLD