IREDELL COUNTY HEALTH DEPARTMENT

STATESVILLE 704-878-5305 MOORESVILLE 704-664-5281

IMPROVEMENT PERMIT / AUTHORIZATION TO CONSTRUCT / OPERATION PERMIT / EXISTING SYSTEM INSPECTION

PERMIT# 071646 PIN# 4625941684 4635 04 9773 DATE Aug. 18, '98

OWNER OR CONTRACTOR Crescent Resources Inc. / Arcadia PHONE: Business ~~Business~~ Home

ADDRESS P.O. Box 1003, Charlotte

LOCATION Brawley Sch Rd. TL The Pointe DR. Queen Anne Circle to Easton DR. last lot on left

SUBDIVISION The Pointe BLOCK / SECTION 1A LOT 116 LOT AREA 35,809 sf SITE CLASS. PS DESIGN FLOW 480 gpd L.T.A.R. .03

Septic Tank: 1000 Gallons; STB 338 Date 4-15-02
Pump Tank: 1000 Gallons; PT 27 Date 2-04-02
Pump Make: Model Serial No.
Nitrification Field: No Fields 1 Square Feet 1200 Linear Feet 400
No Lines 4@100' Trench Width 36" Max Trench Bottom Depth 36"

☑ New System ☐ Repair System Type: I, II, (III), IV, V, VI
System Description: pumped PM- 25% Reduction
Repair System Description: LP Panel Block
Maintenance Agreement Required: ☐ Yes ☑ No
Gravel Depth NA

☑ House/Mod. Home ☐ Mobile Home ☐ Business ☐ Other
No. Bedrooms 4 No. Bathrooms 4 No. Employees
☑ Slab ☑ Crawl Space ☑ Basement w/plumbing ☐ Basement wo/plumbing


Water Supply: ☐ Individual ~~☐ Public~~ ☑ Community

Comments:/Conditions: * ONE INspection port per LATERAL.
Remove any old burning terraced


Comments:/Conditions: (PARTIAL)
Reviewed plans 12-10-01, in Compliance with Septic permit. MD
Tanks & lines Checked 5/29/02

1"=50'

INITIAL SITE SKETCH

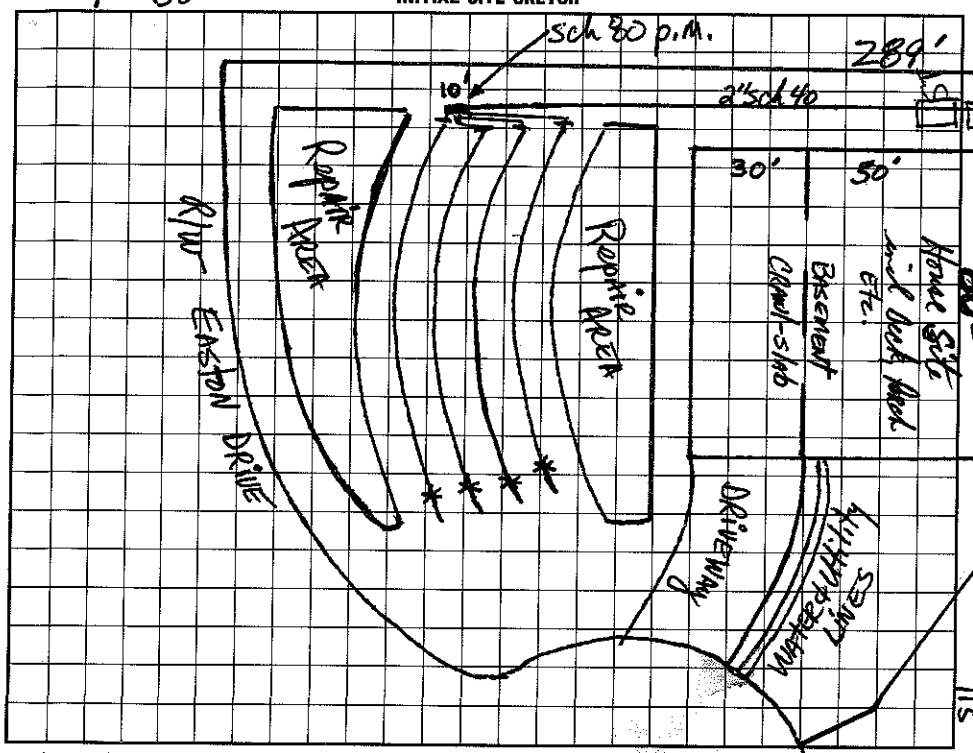

AS BUILT SKETCH Pres. elect & alarm 9/10/2002

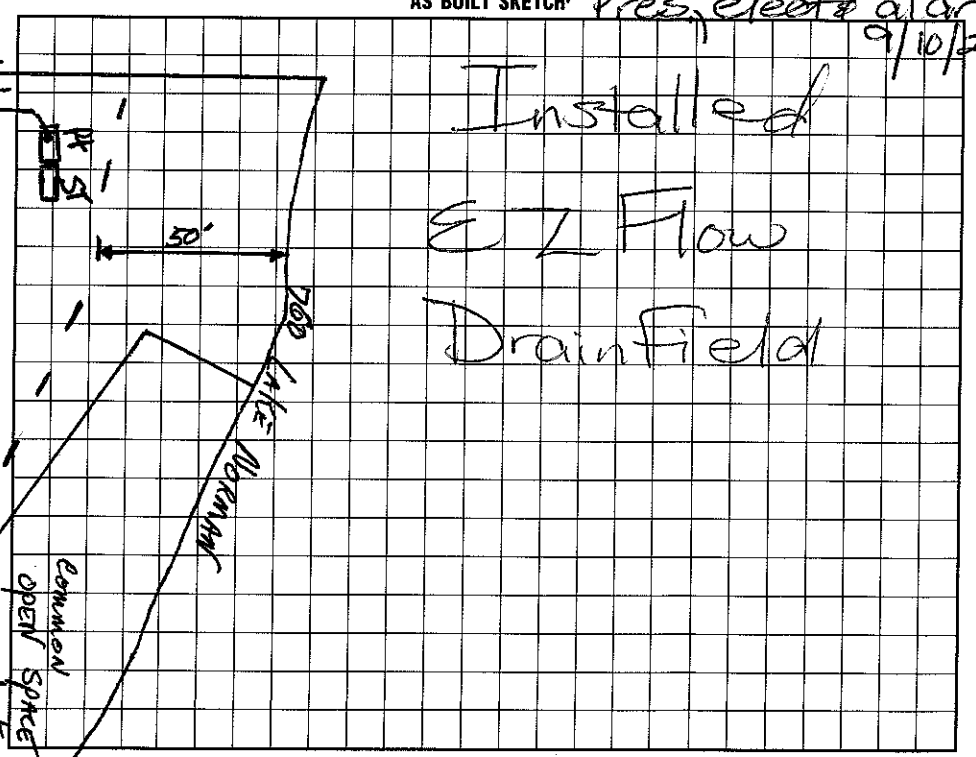

I understand that this permit can be suspended or revoked if any false information is supplied toward securing the permit/any unauthorized changes are made to the site/any unauthorized changes are made in the installation of the system. Improvement Permit with plat valid without expiration. Improvement Permit with site plan valid for sixty months. Authorization to Construct is valid for a period equal to that of Improvement Permit – not to exceed sixty months.

Signed: Paul G. Rogers date 8-2-98

Improvement Permit by: [illegible] R.S. date 8-18-98

Authorization to Construct by: Maina H. Nelson R.S. date 12-10-01

Installed by: R & H R.S.

Operation Permit by: Maina H. Nelson date 9/10/2002

Existing System Inspection by: date

HEALTH DEPT. COPY: WHITE INSPECTION COPY (FINAL): GREEN OWNER COPY (FINAL): YELLOW INSPECTION COPY (INITIAL): PINK OWNER COPY (INITIAL): GOLD