IREDELL COUNTY HEALTH DEPARTMENT

Statesville Office (704) 878-5305 | Mooresville Office (704) 660-3625 | PERMIT # 181709 (Pool 208377)

IMPROVEMENT PERMIT / AUTHORIZATION TO CONSTRUCT / OPERATION PERMIT / EXISTING SYSTEM

PIN # 4635052580

APPLICANT: Sean Cassidy | APPLICANT ADDRESS: 150 Chatham Rd Mooresville, NC 28117

SITE ADDRESS: 150 Chatham Rd - Mooresville, NC | PHONE: | ALT. PHONE:

SITE DIRECTIONS: Brawley School Rd TL Chatham on right

SUBDIVISION: The Point on Norman | SECTION: 1B | LOT # 3 | LOT AREA: 1.29 Ac | DESIGN FLOW: 600 | L.T.A.R.: .3


Septic Tank	1500 (gal)	STB	5338	Date	4-6-15	☐ New System ☐ Repair ☐ Expansion	System Type: I II III IV V VI	☒ Residence	No. Bedrooms	5	Water Supply
Pump Tank	1500 (gal)	PT	477	Date	4-8-15	System Description:	Pump-LP-PPBPS	☐ Business	No. Persons	10	☐ Private
Pump Make		Model		Serial #		Repair System Description:	Same	☐ Other	No. Employees		☐ Public
# Nitrification Fields	1	# Lines	4	Linear Ft:	335'	Maintenance Agreement Required:	☒ YES ☐ NO	☐ Slab	☐ Crawl Space		☒ Community
Trench Width	min 24"	Max. Trench Bottom Depth	36"	Gravel Depth	N/A		☐ GRAVITY ☒ PRESSURE	☒ Basement w/plumbing		☐ Basement w/o plumbing	

Comments / Conditions: *Follow Crescent Communities On Site Sewage System Guidelines
Keep Septic System at least 15ft from Pool Cut


*Site evaluation & Septic plan in attached plan by Michael Athbans & Assoc
Installed 4 lines @ 84'

INITIAL SITE SKETCH

Note: Supply line over tanks.
Scale 1:50

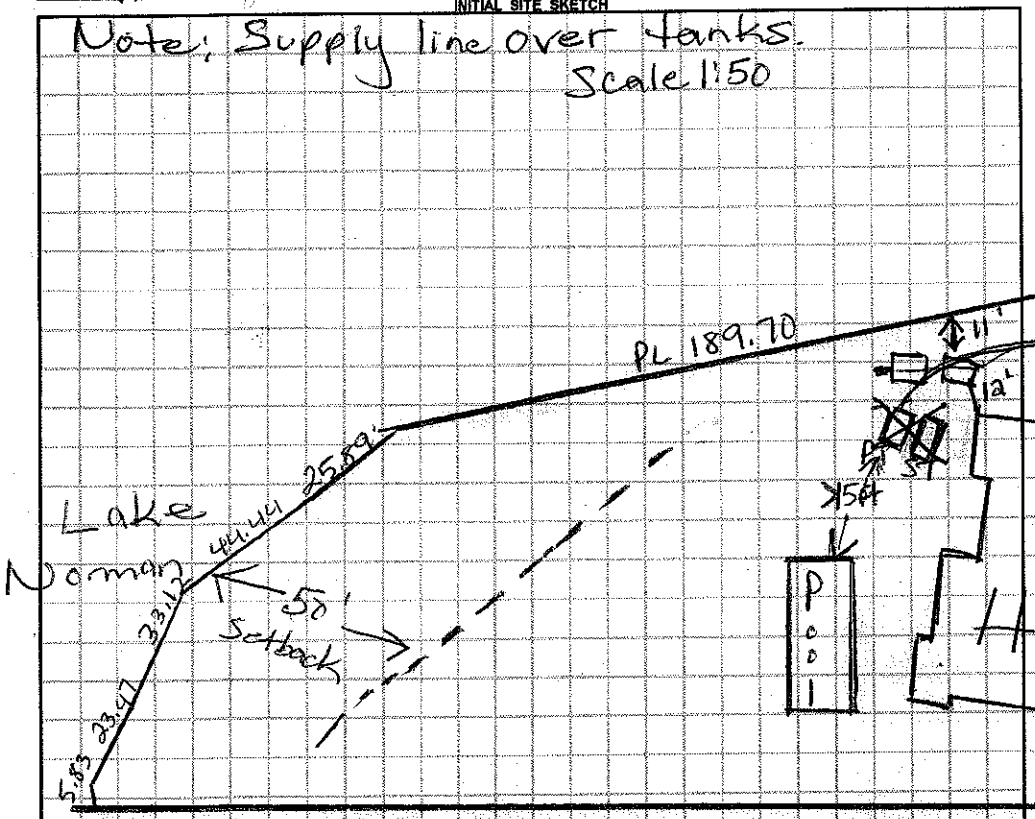

AS BUILT SKETCH

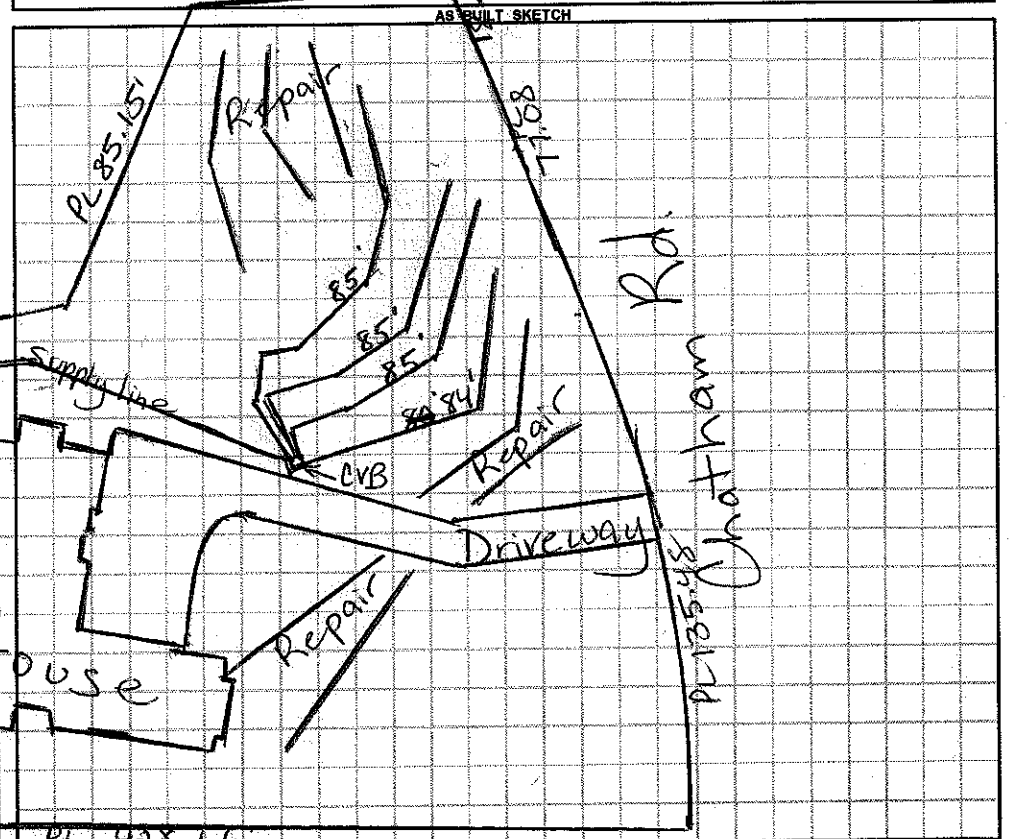

Permit can be suspended or revoked if any false information is supplied toward securing the permit / any unauthorized changes are made to the site / any unauthorized changes are made in the installation of the system. **CONTACT A LOCATOR SERVICE PRIOR TO ANY EXCAVATION**

☐ **IMPROVEMENT PERMIT** *with plat valid without expiration.* ☐ **IMPROVEMENT PERMIT** *with site plan valid for 60 mos.* ☒ **AUTHORIZATION TO CONSTRUCT** *valid for period equal to IMPROVEMENT PERMIT--not to exceed 60 mo.*

Owner / Applicant Signature: [signature] Date: 3/9/15

IMPROVEMENT PERMIT by: Maria H Dotson RS Date: 2/24/15

AUTHORIZATION TO CONSTRUCT by: Maria H Dotson RS Date: 2/24/15

Installed by: R & H

OPERATION PERMIT by: Maria H Dotson RS Date: 10/21/15

Existing System Inspected by: Date:

Health Dept. Copy - WHITE Applicant (Final Approval) - YELLOW Applicant (Conditional Approval) - PINK