IREDELL COUNTY HEALTH DEPARTMENT

STATESVILLE 704-878-5305 MOORESVILLE 704-664-5281

IMPROVEMENT PERMIT / AUTHORIZATION TO CONSTRUCT / OPERATION PERMIT / EXISTING SYSTEM INSPECTION

PERMIT# ~~07-3958~~ 12482O PIN# ~~4625 41 1697~~ 4635 05 2758 DATE 10/18/04

OWNER OR CONTRACTOR Kingswood Custom PHONE: Business 704-506-3456 Home

ADDRESS 8633 Carpet Dr. Ste 400 Charlotte, NC 28226

LOCATION 1100 Tl Chatham Lot on Corner of Mayfair and Chatham

SUBDIVISION Point BLOCK / SECTION 1B LOT 56 LOT AREA 38,818 SITE CLASS. PS DESIGN FLOW 600 L.T.A.R. .3

Septic Tank: 1500 Gallons; STB 338 Date 9/4/05

Pump Tank: 1500 Gallons; PT 477 Date 9/3/05

Pump Make: Gou/ds Model WPE 3/2 MU Serial No.

Nitrification Field: No Fields 1 Square Feet 720/1080 Linear Feet 360

No Lines 4@90 Trench Width 2-3 Max Trench Bottom Depth 3 Gravel Depth No

[X] New System [ ] Repair System Type: I, II, III, IV, V, VI

System Description: Pump Dosed - 16" APBAS

Repair System Description: Same

Maintenance Agreement Required: [X] Yes [ ] No

[X] House/Mod. Home No. Bedrooms 5

[ ] Mobile Home No. Bathrooms 4.5

[ ] Business No. Employees

[ ] Other

[ ] Slab [X] Crawl Space [ ] Basement w/plumbing [ ] Basement wo/plumbing


Water Supply: [ ] Individual [ ] Public [X] Community Point

Comments:/Conditions:


Comments:/Conditions:

INITIAL SITE SKETCH

(1" = 40')

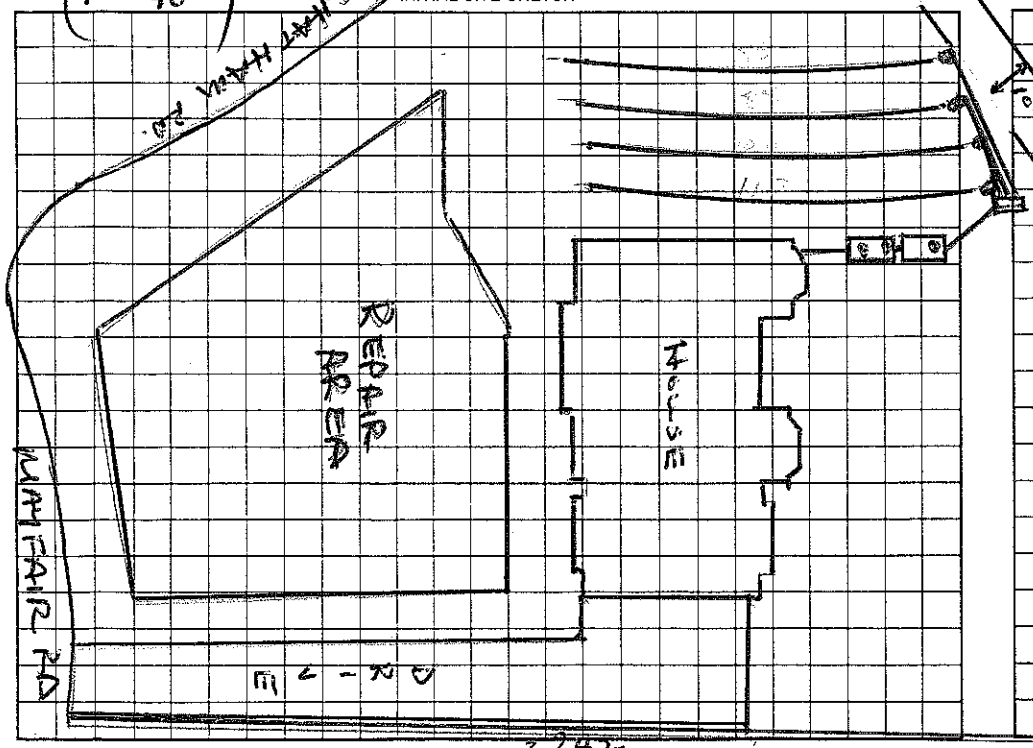

AS BUILT SKETCH

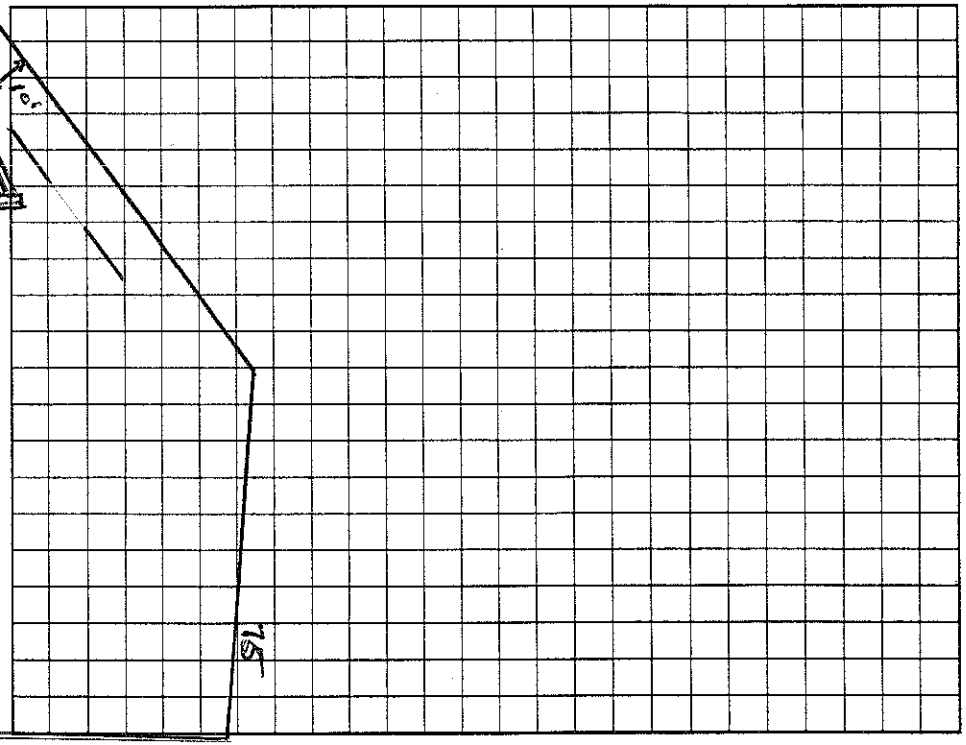

Permit can be suspended or revoked if any false information is supplied toward securing the permit/any unauthorized changes are made to the site/any unauthorized changes are made in the installation of the system. Improvement Permit with plat valid without expiration. Improvement Permit with site plan valid for sixty months. Authorization to Construct is valid for a period equal to that of Improvement Permit – not to exceed sixty months.

Signed: * date

Improvement Permit by: Wesley Sparks R.S. date 10/18/04

Authorization to Construct by: Wesley Sparks R.S. date 10/18/04

Installed by: Hallman Const.

Operation Permit by: RS date 6/7/05

Existing System Inspection by: date

HEALTH DEPT. COPY: WHITE OWNER COPY (FINAL): YELLOW OWNER COPY (INITIAL): PINK