IREDELL COUNTY HEALTH DEPARTMENT

STATESVILLE 704-878-5305 MOORESVILLE 704-664-5281

IMPROVEMENT PERMIT / AUTHORIZATION TO CONSTRUCT / OPERATION PERMIT / EXISTING SYSTEM INSPECTION

PERMIT# 137507 PIN# 4635 05 2992 DATE 9/9/06

OWNER OR APPLICANT David Dibble Custom Homes PHONE: Business 704 799 1488 Home

ADDRESS PO Box 4717 Mooresville, NC. 28117

LOCATION 1100 TL Chatham Rd. TL Mayfair Rd. on (D corner

SUBDIVISION Point BLOCK / SECTION 1-B LOT 55 LOT AREA ~34,000 FT² SITE CLASS. PS DESIGN FLOW 480 L.T.A.R. .3

Septic Tank: 1500 Gallons; STB 444 Date 11/21/06

Pump Tank: Gallons; PT Date

Pump Make: Model Serial No.

Nitrification Field: No Fields 1 Square Feet 1200 Linear Feet 400

No Lines 5 @ 80 Trench Width 3' Max Trench Bottom Depth 3'

[X] New System ☐ Repair ☐ Expansion System Type: I II [III] IV V VI

System Description: Chamber - 25% Reduced

Repair System Description: Presbure - PBPS

Maintenance Agreement Required: ☐ Yes ☐ No

[X] House/Mod. Home ☐ Mobile Home ☐ Business ☐ Other

No. Bedrooms 4 No. Persons No. Employees


Water Supply: ☐ Individual ☐ Public [X] Community

Gravel Depth No ☐ Gravity ☐ Pressure ☐ Slab [X] Crawl Space ☐ Basement w/plumbing ☐ Basement wo/plumbing


Comments:/Conditions:

Comments:/Conditions:

INITIAL SITE SKETCH (1" = 50')

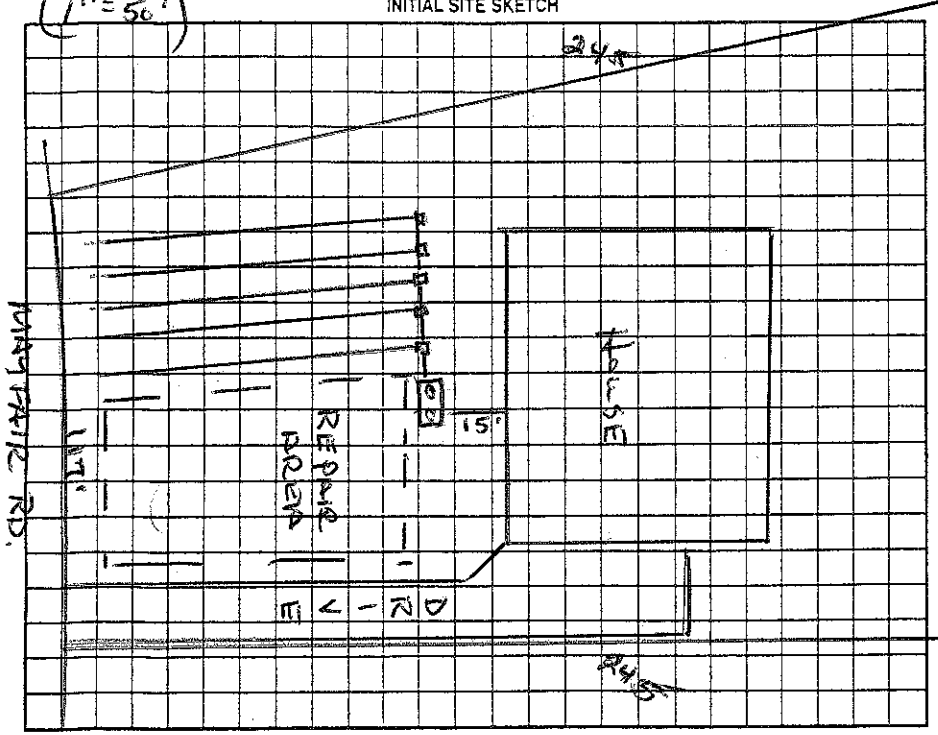

AS BUILT SKETCH

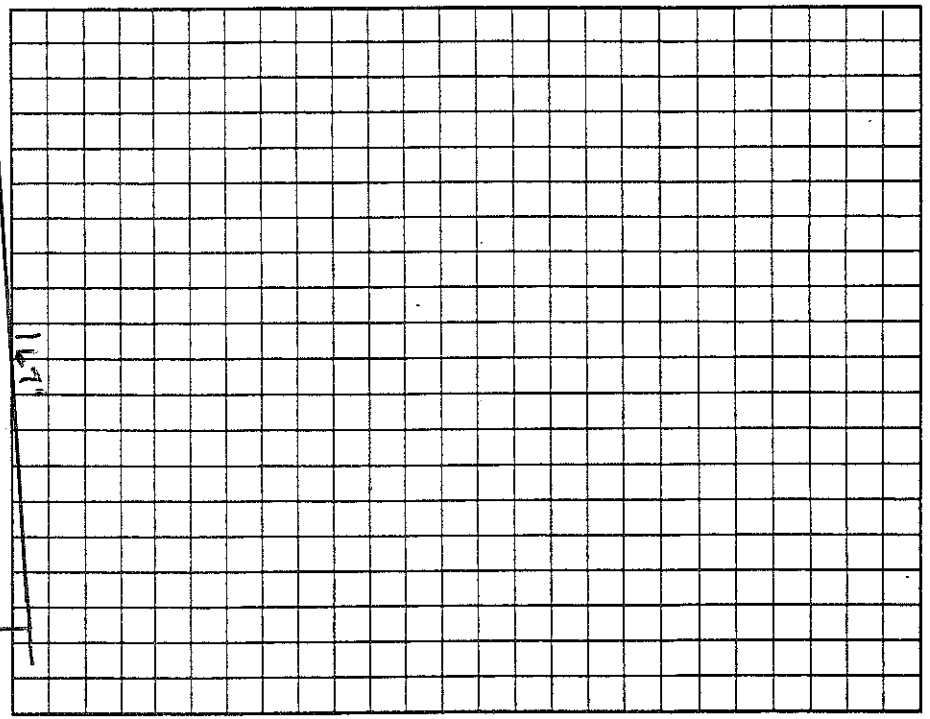

Permit can be suspended or revoked if any false information is supplied toward securing the permit/any unauthorized changes are made to the site/any unauthorized changes are made in the installation of the system. Improvement Permit with plat valid without expiration ☐ Improvement Permit with site plan valid for sixty months ☐ Authorization to Construct is valid for a period equal to that of Improvement Permit – not to exceed sixty months.

Signed: * Crystal Dibble date 9/12/06

Improvement Permit by: Wesley Sparks R.S. date 9/9/06

Authorization to Construct by: Wesley Sparks RS date 9/9/06

Installed by: Osborn & Sons

Operation Permit by: Wesley Sparks R.S. date 1/12/07

Existing System Inspection by: date

HEALTH DEPT. COPY: WHITE OWNER COPY (FINAL): YELLOW OWNER COPY (INITIAL): PINK