IREDELL COUNTY HEALTH DEPARTMENT

STATESVILLE 704-878-5305 MOORESVILLE 704-664-5281

4635-05-4526 2.0

IMPROVEMENT PERMIT / AUTHORIZATION TO CONSTRUCT / OPERATION PERMIT / EXISTING SYSTEM INSPECTIO.

PERMIT# 11421O (Formerly 07384) PIN# 4635944684 Tom Stevenson Dale 201-7273 DATE 7/23/03

OWNER OR CONTRACTOR John Donoghue / Tom Stevenson PHONE: Business 660-6638 Home

ADDRESS 631 Brawley School Rd Ste 503 Mooresville, NC 28117

LOCATION Brawley School Rd TL Chatham Rd On right

SUBDIVISION The Point BLOCK / SECTION 1-B LOT 4 LOT AREA 48,979 SF SITE CLASS. PS DESIGN FLOW 480 gpd L.T.A.R. .25-.3

Septic Tank: 1000+ Gallons; STB 338 Date 3-5-04 ☒ New System ☐ Repair System Type: I, II, III, (IV) V, VI ☒ House/Mod. Home No. Bedrooms 4

Pump Tank: 1000 Gallons; PT 283 Date 3-5-04 System Description: Pump-LP-Panel Block ☐ Mobile Home No. Bathrooms 4

Pump Make: Myers Model ME1502 Serial No. Repair System Description: Same ☐ Business No. Employees

Nitrification Field: No Fields 1 Square Feet 900 Linear Feet 300 Maintenance Agreement Required: ☒ Yes ☐ No ☐ Other


No Lines 6@50' Trench Width 36" Max Trench Bottom Depth ~30" Gravel Depth N/A ☐ Slab ☐ Crawl Space ☒ Basement w/plumbing ☐ Basement wo/plumbing

Water Supply: ☐ Individual ☒ Public ☒ Community


Comments:/Conditions: Keep Septic System at least 10' from PL, 15' from cut 2' or greater (eroded area), 50' from lake, 15' from swimming pool & 25' from basement wall.

Comments:/Conditions: Checked tanks, 5 of 6 lines 4/7/04
Checked last line 4/8/04

INITIAL SITE SKETCH Scale 1:50

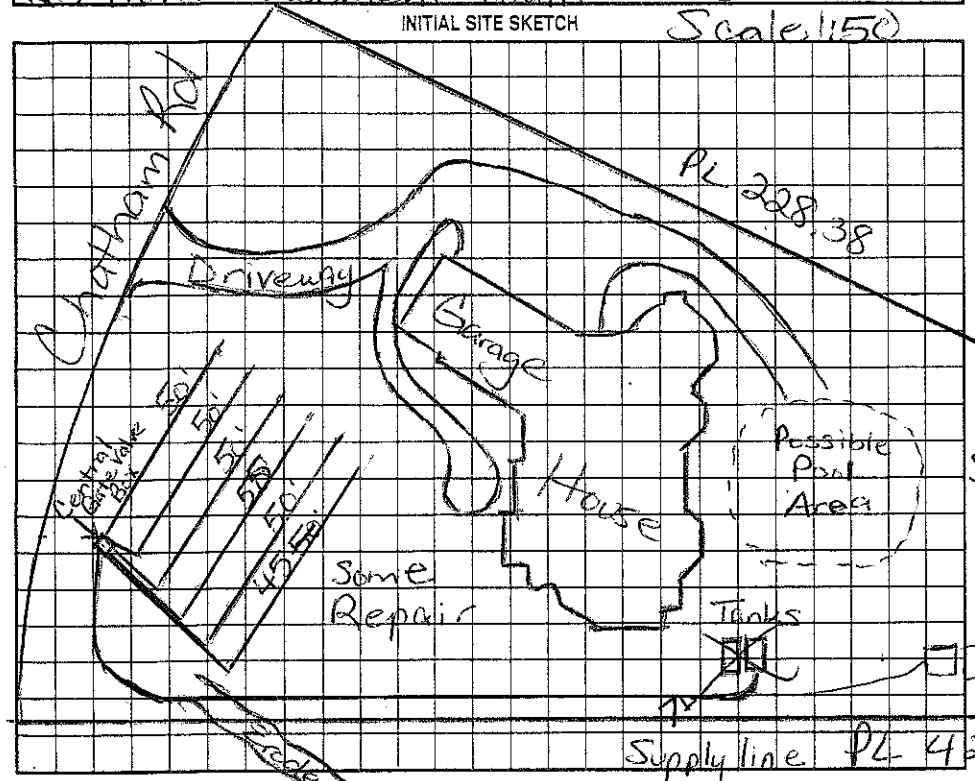

AS BUILT SKETCH

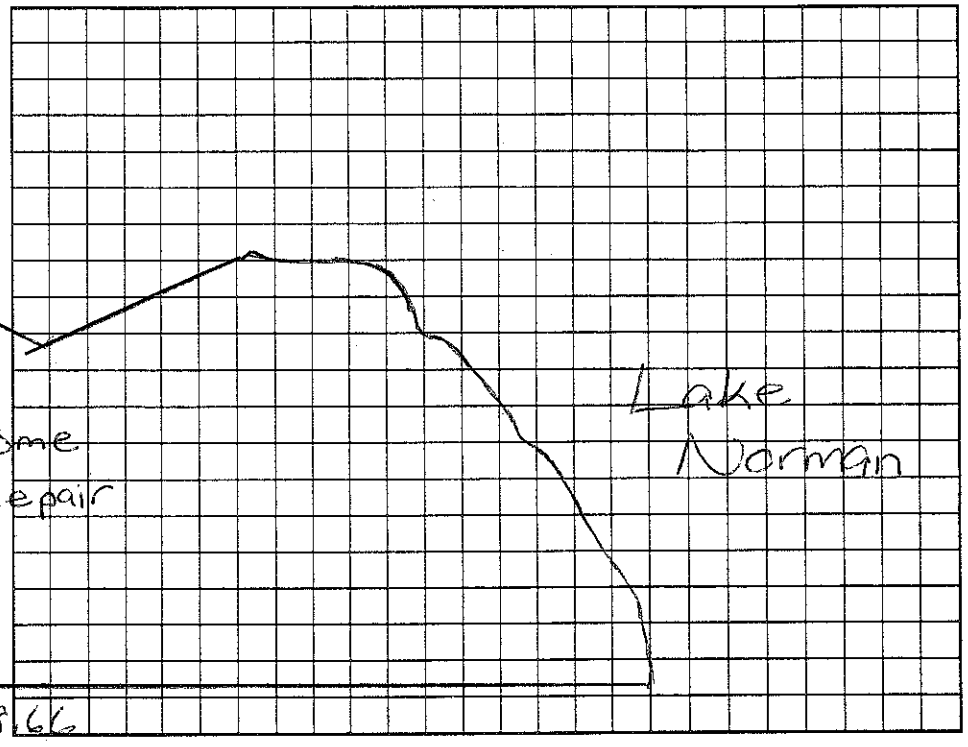

Permit can be suspended or revoked if any false information is supplied toward securing the permit/any unauthorized changes are made to the site/any unauthorized changes are made in the installation of the system. Improvement Permit with plat valid without expiration. Improvement Permit with site plan valid for sixty months. Authorization to Construct is valid for a period equal to that of Improvement Permit – not to exceed sixty months.

Signed: _____ date _____ Installed by: R & F

Improvement Permit by: Maria H. Dotson RS date 7/23/03 Operation Permit by: Maria H. Dotson RS date 6/16/04

Authorization to Construct by: Maria H. Dotson RS date 7/23/03 Existing System Inspection by: _____ date _____

HEALTH DEPT. COPY: WHITE OWNER COPY (FINAL): YELLOW OWNER COPY (INITIAL): PINK