IREDELL COUNTY HEALTH DEPARTMENT

STATESVILLE 704-878-5305 MOORESVILLE 704-664-5281

IMPROVEMENT PERMIT / AUTHORIZATION TO CONSTRUCT / OPERATION PERMIT / EXISTING SYSTEM INSPECTION

PERMIT# 130380 PIN# 4635055554 Doug DATE 12-20-05

OWNER OR CONTRACTOR Jason & Nikki Willis PHONE: Business (704)361-9604 Home McBride

ADDRESS 168 Chatham Mooresville NC 28117

LOCATION Brawley School Rd To Chatham Rd 2nd house on right

SUBDIVISION The Point BLOCK / SECTION F-B LOT 5 LOT AREA .77Acre SITE CLASS PS DESIGN FLOW 480gpd L.T.A.R. .3

Septic Tank: 1500 Gallons; STB 338 Date 12-20-99 (Existing)
Pump Tank: 1000 Gallons; PT 27 Date 8-17-99
Pump Make: Model Serial No.
Nitrification Field: No Fields 1 Square Feet 900 Linear Feet 300
No Lines 6@50' Trench Width 36" Max Trench Bottom Depth ~30" Gravel Depth N/A (Existing)

☒ New System ☐ Repair System Type: I, II, III, IV, V, VI
System Description: Pump-LP-Panel Block
Repair System Description: Same
Maintenance Agreement Required: ☒ Yes ☐ No


☒ House/Mod. Home No. Bedrooms 4
☐ Mobile Home No. Bathrooms
☐ Business No. Employees
☐ Other
☐ Slab ☐ Crawl Space ☒ Basement w/plumbing ☐ Basement wo/plumbing

Water Supply: ☐ Individual ☒ Public ☒ Community


Comments:/Conditions: Note: Septic tank (ST) & Pumptank (PT) to close to pool (under construction) therefore tanks need to be relocated > 15Ft from pool cut.

Comments:/Conditions: Minimize traffic over existing Drainfield
Sneaked relocation of tanks 1/20/06
Pressure, elect & alarm 2/24/06 [illegible]

Scale 1:50 INITIAL SITE SKETCH

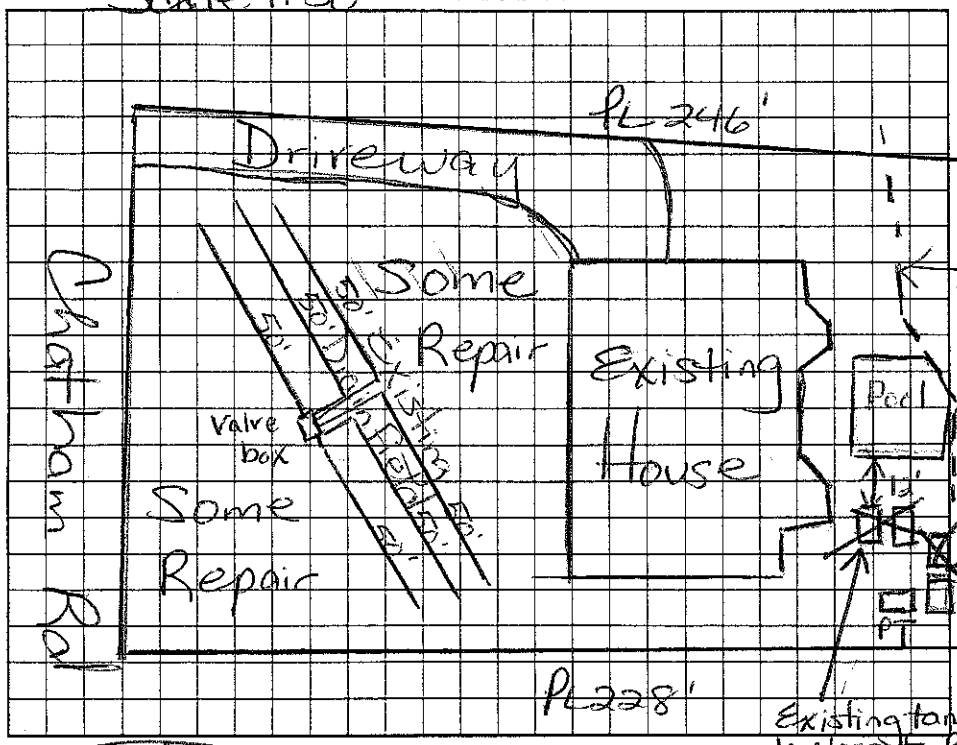

AS BUILT SKETCH

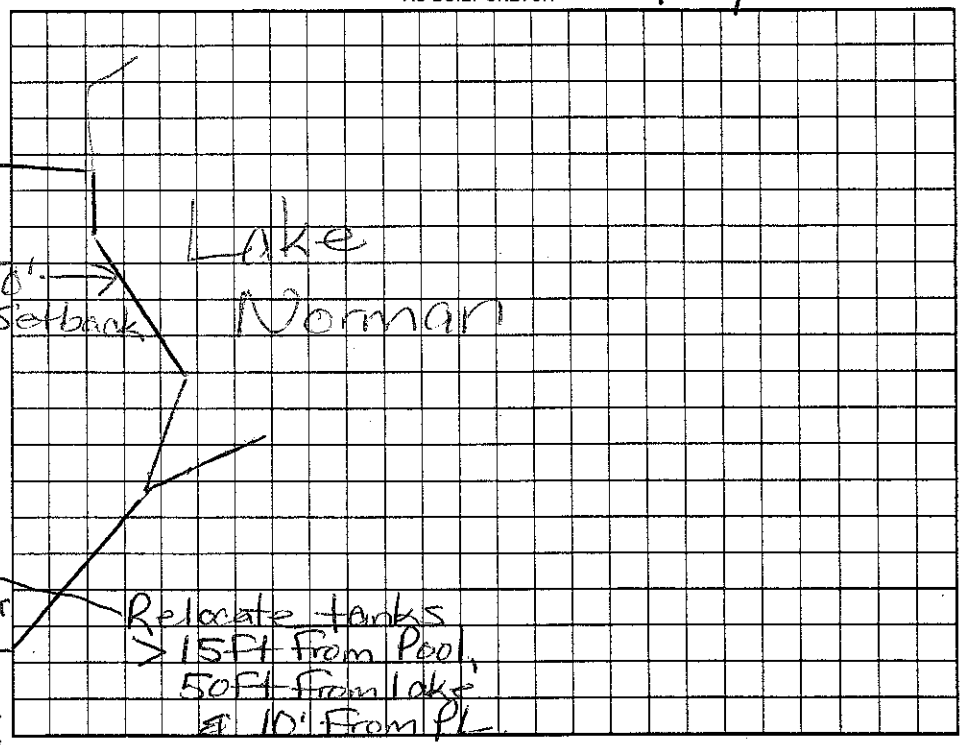

Permit can be suspended or revoked if any false information is supplied toward securing the permit/any unauthorized changes are made to the site/any unauthorized changes are made in the installation of the system. Improvement Permit with plat valid without expiration. Improvement Permit with site plan valid for sixty months. Authorization to Construct is valid for a period equal to that of Improvement Permit – not to exceed sixty months.

Signed: [signature] date

Improvement Permit by: Maria H. Nelson RS date 12/20/05

Authorization to Construct by: Maria H. Nelson RS date 12/20/05

Installed by: R. H. Nelson RS

Operation Permit by: Maria H. Nelson RS date

Existing System Inspection by: Maria H. Nelson RS date 2/24/06

HEALTH DEPT. COPY: WHITE OWNER COPY (FINAL): YELLOW OWNER COPY (INITIAL): PINK