10:00

IREDELL COUNTY HEALTH DEPARTMENT

STATESVILLE 704-878-5305 MOORESVILLE 704-664-5281

IMPROVEMENT PERMIT / AUTHORIZATION TO CONSTRUCT / OPERATION PERMIT / EXISTING SYSTEM INSPECTION

PERMIT# 073865 PIN# 4625941684 4635-05-5554 DATE Sept. 10, '98

OWNER OR CONTRACTOR Crescent Resources Inc. // Dienst Custom Homes PHONE: Business _____ Home _____

ADDRESS P.O. Box 1003, Charlotte

LOCATION Brawley Sch. Rd. TL Chatham Road on Right #16 &

SUBDIVISION The Pointe BLOCK / SECTION 1-B LOT 5 LOT AREA 32,548 SF SITE CLASS. PS DESIGN FLOW 4 bedroom L.T.A.R. .3

Septic Tank: Fiber 1500 Gallons; STB 338 Date 12-20-99

Pump Tank: 1000 Gallons; PT 27 Date 8-17-99

Pump Make: _____ Model _____ Serial No. _____

Nitrification Field: No Fields 1 Square Feet 900 Linear Feet 300

No Lines 6@50 Trench Width 36" Max Trench Bottom Depth ~30" Gravel Depth NA

☑ New System ☐ Repair System Type: I, II, III, IV, V, VI

System Description: LP Panel Block

Repair System Description: Same

Maintenance Agreement Required: ☑ Yes ☐ No

☑ House/Mod. Home No. Bedrooms 4

☐ Mobile Home No. Bathrooms 4

☐ Business No. Employees _____

☐ Other _____

☑ Slab ☑ Crawl Space ☐ Basement w/plumbing ☐ Basement wo/plumbing

Water Supply: ☐ Individual ☑ Public ☐ Community

Comments:/Conditions: Remove any old burns & Fill ERODED & Gulled AREAS.

5-25-99 Reviewed house footeplan- appears in compliance w/ Info


Comments:/Conditions: (PARTIAL) Riser & Filter installed

Tanks & lines inspected 3/8/2000


Note: New revised permit done 12-20-05

1"=50'

INITIAL SITE SKETCH

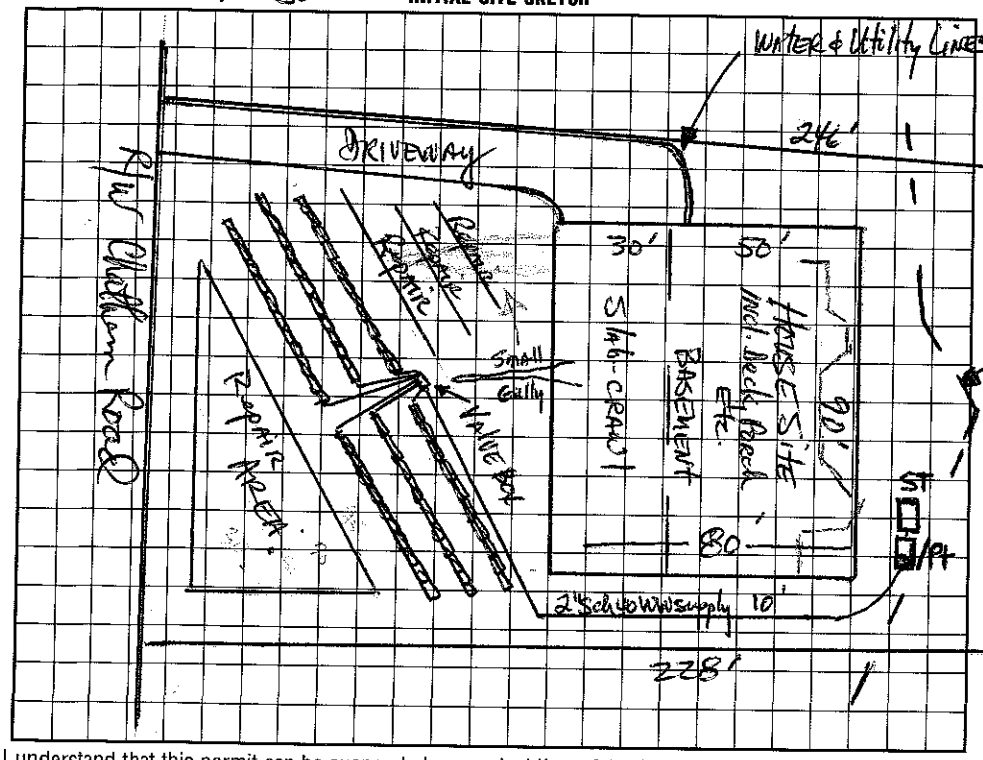

AS BUILT SKETCH

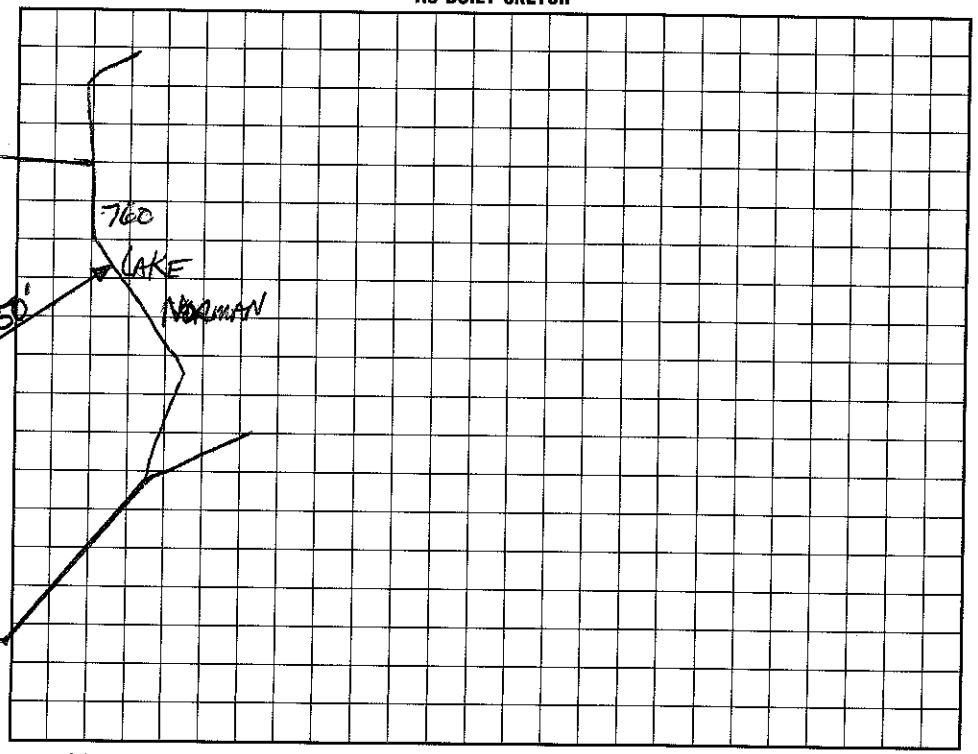

I understand that this permit can be suspended or revoked if any false information is supplied toward securing the permit/any unauthorized changes are made to the site/any unauthorized changes are made in the installation of the system. Improvement Permit with plat valid without expiration. Improvement Permit with site plan valid for sixty months. Authorization to Construct is valid for a period equal to that of Improvement Permit – not to exceed sixty months.

Signed: Tony C Jones (PS) Agent date 10-15-98

Improvement Permit by: Dave R Thompson, RS date 9-10-98

Authorization to Construct by: Dave R Thompson, RS date 5-25-99

Installed by: R & H Inc

Operation Permit by: Maria H Dobson RS date 3/31/2000

Existing System Inspection by: _____ date _____

HEALTH DEPT. COPY: WHITE INSPECTION COPY (FINAL): GREEN OWNER COPY (FINAL): YELLOW INSPECTION COPY (INITIAL): PINK OWNER COPY (INITIAL): GOLD