IREDELL COUNTY HEALTH DEPARTMENT

STATESVILLE 704-878-5305 MOORESVILLE 704-664-5281

IMPROVEMENT PERMIT / AUTHORIZATION TO CONSTRUCT / OPERATION PERMIT / EXISTING SYSTEM INSPECTION

PERMIT# 122884 PIN# 4635055987 DATE 9-28-05

OWNER OR CONTRACTOR Zande Homes PHONE: Business 375-5999 Home 363-2898

ADDRESS 909 C East Blvd Charlotte, NC 28203

LOCATION Brawley School Rd TL Chatham TL Mayfair on right 2nd lot

SUBDIVISION The Point BLOCK / SECTION 1-B LOT 18 LOT AREA .56 SITE CLASS. PS DESIGN FLOW 480gpd L.T.A.R. .3

Septic Tank: 1000+ Gallons; STB 338 Date 10-28-05 ☒ New System ☐ Repair System Type: I, II, III, IV, V, VI

Pump Tank: 1000 Gallons; PT 383 Date 12-03-05 System Description: Pump-LP-Panel Blk

Pump Make: Goulds Model WE0312M Serial No. L057904 Repair System Description: Same

Nitrification Field: No Fields 1 Square Feet 840' Linear Feet 280' Maintenance Agreement Required: ☒ Yes ☐ No

No Lines 4 Trench Width 24-36" Max Trench Bottom Depth 30" Gravel Depth N/A

☒ House/Mod. Home No. Bedrooms 4

☐ Mobile Home No. Bathrooms ___

☐ Business No. Employees ___

☐ Other ___


☐ Slab ☒ Crawl Space ☐ Basement w/plumbing ☐ Basement wo/plumbing

Water Supply: ☒ Individual ☐ Public ☐ Community

Comments:/Conditions: Can not put "Concrete" Walkway over drainlines; keep walkway above Drainfield.

Comments:/Conditions: Very tight Lot - DO NOT Cut Down for House Checked tanks & lines 2/10/06 MS

INITIAL SITE SKETCH

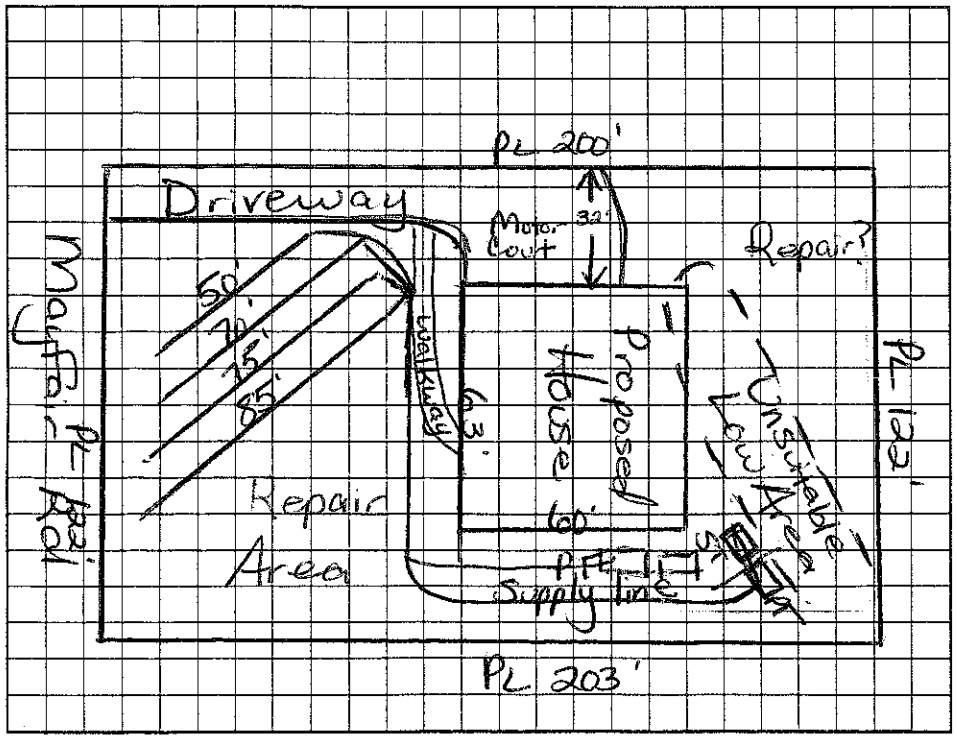

AS BUILT SKETCH

Installed lines as Drawn

Permit can be suspended or revoked if any false information is supplied toward securing the permit/any unauthorized changes are made to the site/any unauthorized changes are made in the installation of the system. Improvement Permit with plat valid without expiration. Improvement Permit with site plan valid for sixty months. Authorization to Construct is valid for a period equal to that of Improvement Permit – not to exceed sixty months.

Signed: Shelby Dodd date 9/30/05 Installed by: Bobby Mayhew RS

Improvement Permit by: Maria H Dotson RS date 9/28/05 Operation Permit by: Maria H Dotson date 3/29/06

Authorization to Construct by: Maria H Dotson RS date 9/28/05 Existing System Inspection by: ___ date ___

HEALTH DEPT. COPY: WHITE OWNER COPY (FINAL): YELLOW OWNER COPY (INITIAL): PINK