IREDELL COUNTY HEALTH DEPARTMENT

Statesville Office (704) 878-5305 Mooresville Office (704) 660-3625 PERMIT # 211958

IMPROVEMENT PERMIT / AUTHORIZATION TO CONSTRUCT / OPERATION PERMIT / EXISTING SYSTEM

PIN # 4635-05-5987.000

APPLICANT: Superior Pools APPLICANT ADDRESS: 20315 Knox Rd.

SITE ADDRESS: 114 Mayfair Dr Mooresville NC PHONE: 704-896-7665 ALT. PHONE: 704-490-8062


SITE DIRECTIONS: BR, TL Chatham, TL Mayfair

SUBDIVISION: The Point on Norman SECTION: 1-B LOT # 18 LOT AREA: .56 Acre DESIGN FLOW: Ex. 480 GPD L.T.A.R.: Existing


Septic Tank Existing (gal)	STB	Date	☐ New System ☐ Repair ☐ Expansion System Type: I II III (IV) V VI	☒ Residence	No. Bedrooms Ex. 4	Water Supply
Pump Tank Existing (gal)	PT	Date	System Description: LP - Panel - Existing	☐ Business	No. Persons Ex. 8	☐ Private
Pump Make Existing	Model	Serial #	Repair System Description: LP - Panel	☐ Other	No. Employees	☐ Public
# Nitrification Fields Ex.	# Lines Existing	Linear Ft: Ex.	Maintenance Agreement Required: ☒ YES ☐ NO	☐ Slab	☒ Crawl Space	☒ Community
Trench Width Ex.	Max. Trench Bottom Depth Ex.	Gravel Depth N/A	☐ GRAVITY ☒ PRESSURE	☐ Basement w/plumbing	☐ Basement w/o plumbing	

Comments / Conditions: Existing System Assumed To Be Functioning At Time of Inspection. Maintain 15' Separation With Pool From Tanks.

INITIAL SITE SKETCH

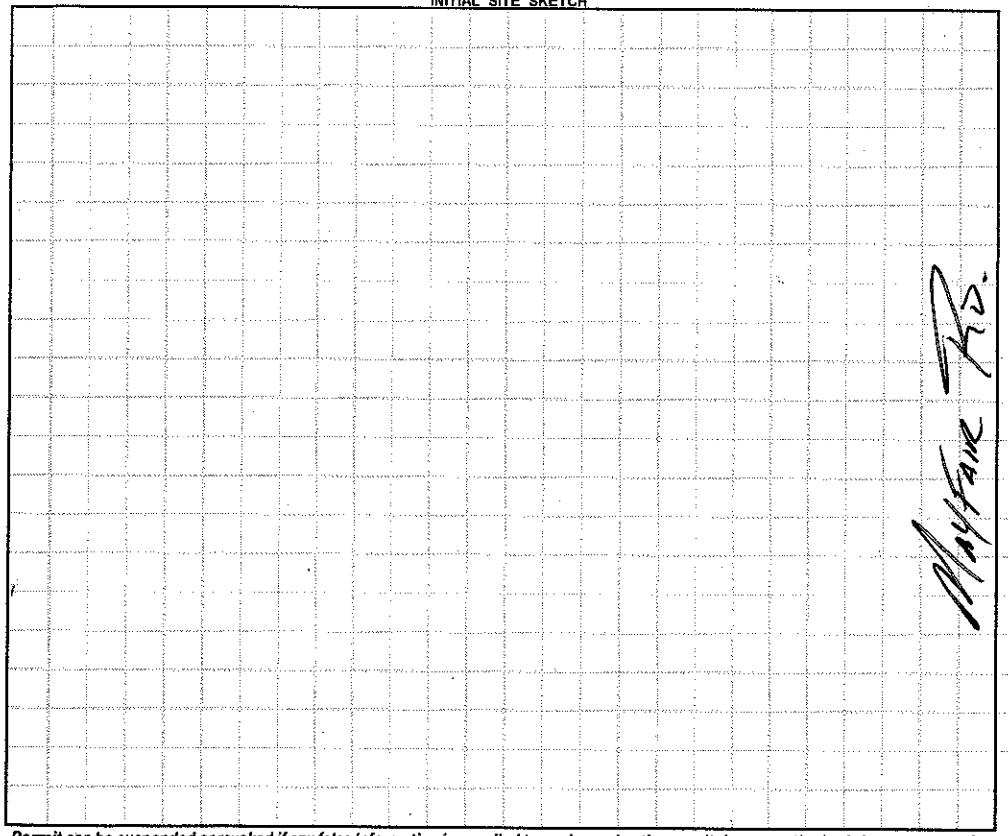

AS BUILT SKETCH

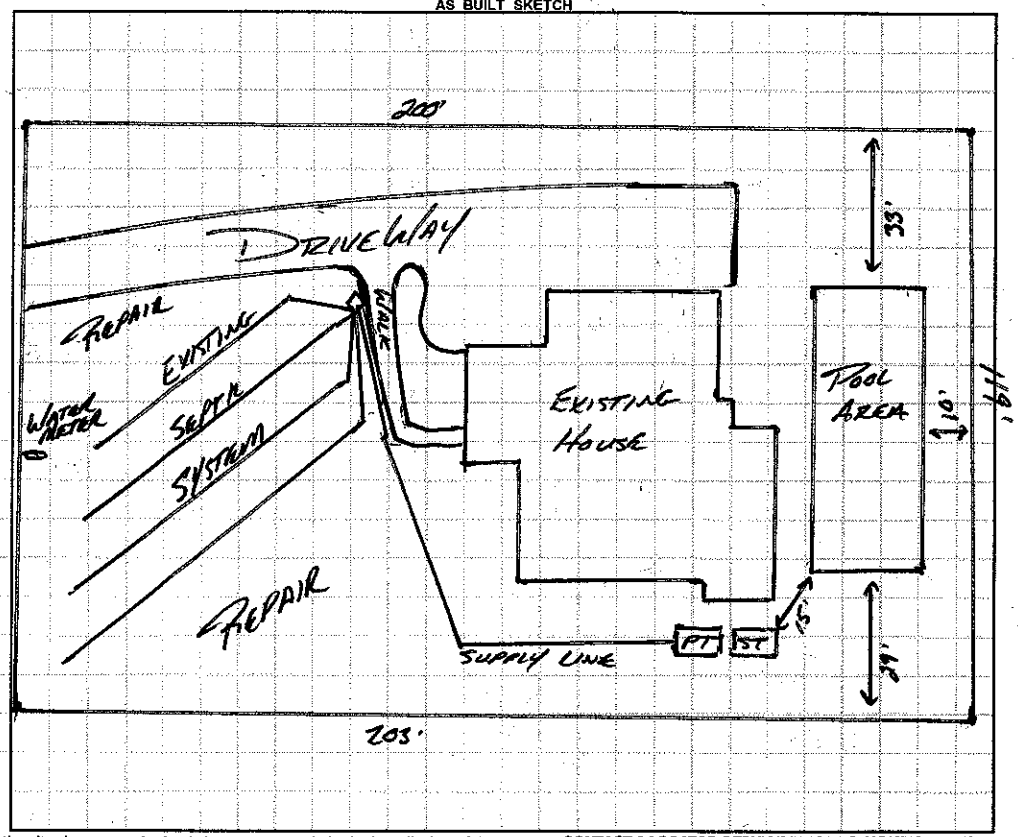

Permit can be suspended or revoked if any false information is supplied toward securing the permit / any unauthorized changes are made to the site / any unauthorized changes are made in the installation of the system. **CONTACT A LOCATOR SERVICE PRIOR TO ANY EXCAVATION**

☐ **IMPROVEMENT PERMIT** *with plat valid without expiration.* ☐ **IMPROVEMENT PERMIT** *with site plan valid for 60 mos.* ☐ **AUTHORIZATION TO CONSTRUCT** *valid for period equal to IMPROVEMENT PERMIT--not to exceed 60 mo.*

Owner / Applicant Signature: Date: 9-6-15 Installed by:

IMPROVEMENT PERMIT by: Date: OPERATION PERMIT by: Date:

AUTHORIZATION TO CONSTRUCT by: Date: Existing System Inspected by: APPROVED Date: JUL 31 2015

Health Dept. Copy - WHITE Applicant (Final Approval) - YELLOW Applicant (Conditional Approval) - PINK