IREDELL COUNTY HEALTH DEPARTMENT

STATESVILLE 704-878-5305 MOORESVILLE 704-664-5281

IMPROVEMENT PERMIT / AUTHORIZATION TO CONSTRUCT / OPERATION PERMIT / EXISTING SYSTEM INSPECTION

10:00

PERMIT# 073866 PIN# 4625944684 (pt.) 4635-05-7506 DATE Sept. 10, '98

OWNER OR CONTRACTOR Crescent Resources Inc. (Noble Const. 176 Graham Rd. on Right) PHONE: Business _____ Home _____

ADDRESS P.O. Box 10031 Charlotte

LOCATION Brawley Sch. Rd. TL Chatham Rd.

SUBDIVISION The Pointe BLOCK / SECTION 1-B LOT 6 LOT AREA 37,799 ft² SITE CLASS. RS DESIGN FLOW 480 gpd L.T.A.R. no 3

Septic Tank: ~~1000~~ +1500 Gallons; STB 338 Date 9/14/03

Pump Tank: 1000 Gallons; PT 263 Date 9/16/03

Pump Make: Goulds Model WE0 STHHU Serial No. _____

Nitrification Field: No Fields 1 Square Feet 840 Linear Feet 280

No Lines 4@70' Trench Width 36" Max Trench Bottom Depth 30" Gravel Depth NA

☑ New System ☐ Repair System Type: I, II, III, IV, V, VI

System Description: LP Panel Block

Repair System Description: Same

Maintenance Agreement Required: ☑ Yes ☐ No

☑ House/Mod. Home No. Bedrooms 4

☐ Mobile Home No. Bathrooms 4

☐ Business No. Employees _____

☐ Other _____

☑ Slab ☑ Crawl Space ☑ Basement w/plumbing ☐ Basement wo/plumbing


Water Supply: ☐ Individual ☑ Public ☐ Community

Comments:/Conditions: Remove Any old Burms, terraces. Fill gullied and eroded areas.

Comments:/Conditions: (PARTIAL)

64 Panels 3/16" holes

INITIAL SITE SKETCH 1"=50'

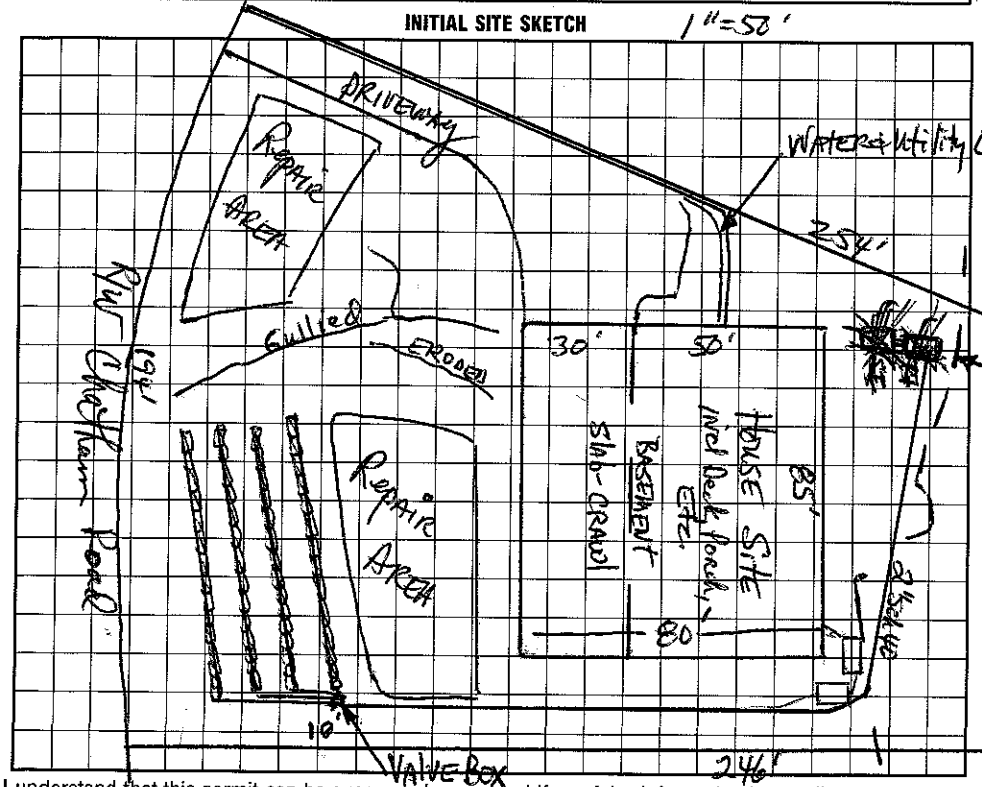

AS BUILT SKETCH

I understand that this permit can be suspended or revoked if any false information is supplied toward securing the permit/any unauthorized changes are made to the site/any unauthorized changes are made in the installation of the system. Improvement Permit with plat valid without expiration. Improvement Permit with site plan valid for sixty months. Authorization to Construct is valid for a period equal to that of Improvement Permit – not to exceed sixty months.

Signed: Tony C Jones (PSS) Agent date 10-15-98 Installed by: O-b: 1500

Improvement Permit by: _____ date 9-10-98

Authorization to Construct by: Wesley Sparks RS date 4/8/03 Operation Permit by: Wesley Sparks RS date 1/22/04

Existing System Inspection by: _____ date _____

HEALTH DEPT. COPY: WHITE INSPECTION COPY (FINAL): GREEN OWNER COPY (FINAL): YELLOW INSPECTION COPY (INITIAL): PINK OWNER COPY (INITIAL): GOLD