IREDELL COUNTY HEALTH DEPARTMENT

Statesville Office (704) 878-5305 Mooresville Office (704) 660-3625 PERMIT # 215245

IMPROVEMENT PERMIT / AUTHORIZATION TO CONSTRUCT / OPERATION PERMIT / EXISTING SYSTEM

PIN # 4635-05-7871

APPLICANT: DEO, LLC APPLICANT ADDRESS: 16888 Summer Hill Dr. Denver

SITE ADDRESS: 177 Chatham Dr. - Mrsvl. PHONE: 704-733-8831 ALT. PHONE:

SITE DIRECTIONS: BSR, TL Chatham, on L

SUBDIVISION: The Point on Norman SECTION: 18 LOT # 15 LOT AREA: .72 AC DESIGN FLOW: 480 L.T.A.R.: 13

Septic Tank 1500 (gal) STB Date

Pump Tank 1000 (gal) PT Date

Pump Make Model Serial #

Nitrification Fields # Lines EXISTING Linear Ft.

Trench Width Max. Trench Bottom Depth Gravel Depth —

☐ New System ☐ Repair ☐ Expansion System Type: I II III (IV) V VI

System Description: LP Panel Block

Repair System Description: SAME

Maintenance Agreement Required: ☑ YES ☐ NO

☐ GRAVITY ☑ PRESSURE

☐ Residence No. Bedrooms 4

☐ Business No. Persons

☑ Other No. Employees

☐ Slab ☐ Crawl Space

☐ Basement w/plumbing ☐ Basement w/o plumbing

Water Supply: ☐ Private ☐ Public ☑ Community

Comments / Conditions:

Pool


INITIAL SITE SKETCH

WATERS EDGE OF POOL MUST BE 15' FROM SEPTIC

CHATHAM RD.

R 158'

AS BUILT SKETCH

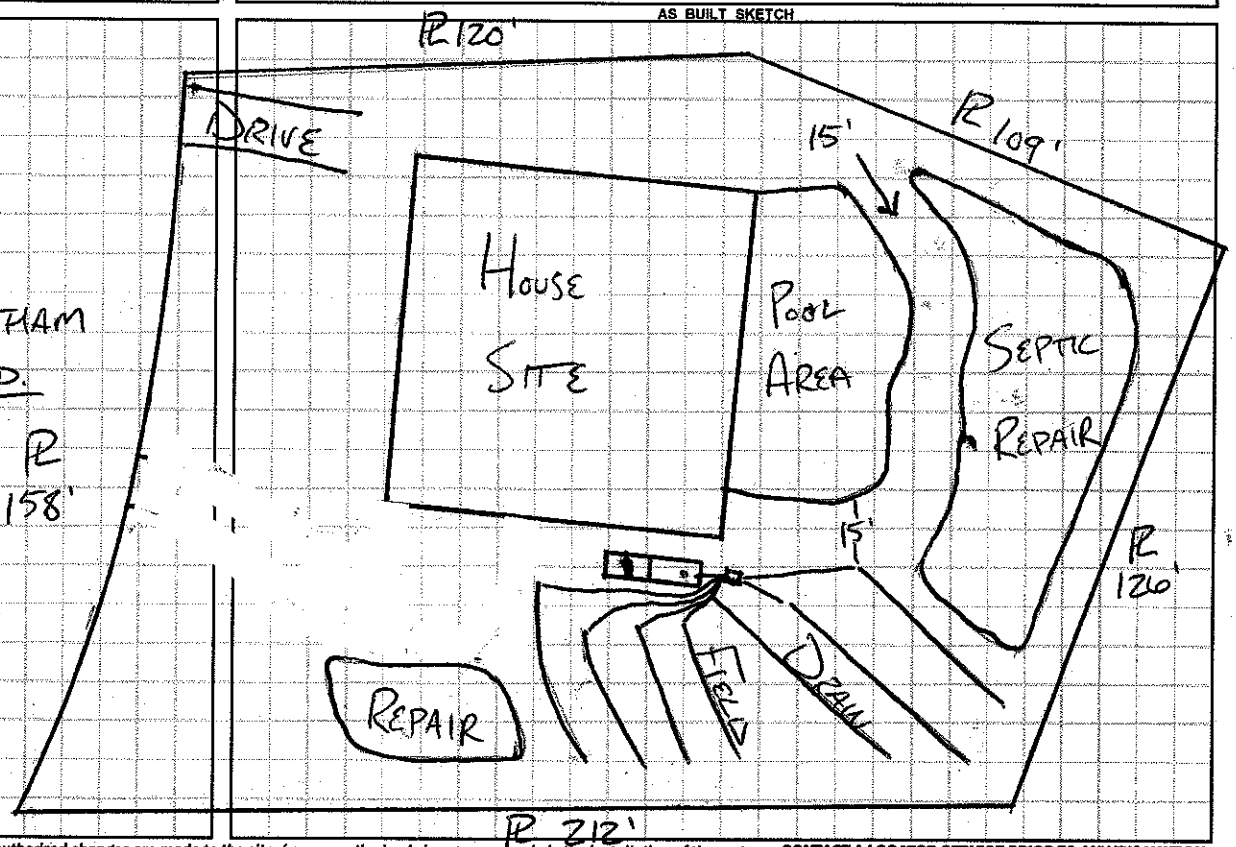

Permit can be suspended or revoked if any false information is supplied toward securing the permit / any unauthorized changes are made to the site / any unauthorized changes are made in the installation of the system. **CONTACT A LOCATOR SERVICE PRIOR TO ANY EXCAVATION**

☐ **IMPROVEMENT PERMIT** *with plat valid without expiration* ☐ **IMPROVEMENT PERMIT** *with site plan valid for 60 mos.* ☐ **AUTHORIZATION TO CONSTRUCT** *valid for period equal to IMPROVEMENT PERMIT--not to exceed 60 mo.*

Owner / Applicant Signature: Date: 1-14-16 Installed by:

IMPROVEMENT PERMIT by: Date: OPERATION PERMIT by: Date:

AUTHORIZATION TO CONSTRUCT by: Date: Existing System Inspected by: Date: 1-8-16

Health Dept. Copy - WHITE Applicant (Final Approval) - YELLOW Applicant (Conditional Approval) - PINK