IREDELL COUNTY HEALTH DEPARTMENT

STATESVILLE 704-878-5305 MOORESVILLE 704-664-5281

IMPROVEMENT PERMIT / AUTHORIZATION TO CONSTRUCT / OPERATION PERMIT / EXISTING SYSTEM INSPECTIO

PERMIT# 073867 PIN# ~~4625741684~~ 4635-05-8541 DATE Sept. 11, '98

OWNER OR CONTRACTOR Crescent Resources Inc. (CORNERSTONE) PHONE: Business ______ Home ______

ADDRESS P.O. Box 1003, Charlotte

LOCATION Brawley School Rd. TL Chatham Rd. on Right at end

SUBDIVISION The Pointe BLOCK / SECTION 1-B LOT 7 LOT AREA 41,689 ft² SITE CLASS. PS DESIGN FLOW 480 gpd L.T.A.R. .3

Septic Tank: 1500 + Gallons; STB 338 Date 11/14/99
Pump Tank: 1000 Gallons; PT 27 Date 8/24/99
Pump Make: ______ Model ______ Serial No. ______
Nitrification Field: No Fields 1 Square Feet 840 Linear Feet 280
No Lines 5 Trench Width 36" Max Trench Bottom Depth ~30" Gravel Depth NA

☑ New System ☐ Repair System Type: I, II, III, (IV), V, VI
System Description: LP Panel Block
Repair System Description: SAME
Maintenance Agreement Required: ☑ Yes ☐ No

☑ House/Mod. Home No. Bedrooms 4
☐ Mobile Home No. Bathrooms 4
☐ Business No. Employees ______
☐ Other ______

☑ Slab ☑ Crawl Space ☑ Basement w/plumbing ☐ Basement wo/plumbing


Water Supply:
☐ Individual
☑ Public
☐ Community

Comments:/Conditions: Fill gullied areas. Remove any old berms, terraces. * Reviewed site & house plan – appears substantially in compliance w/ IP [illegible]


Comments:/Conditions: (partial) Checked lines 12/17/99
** No photography waste can be discharged into septic system

1" = 50'

INITIAL SITE SKETCH

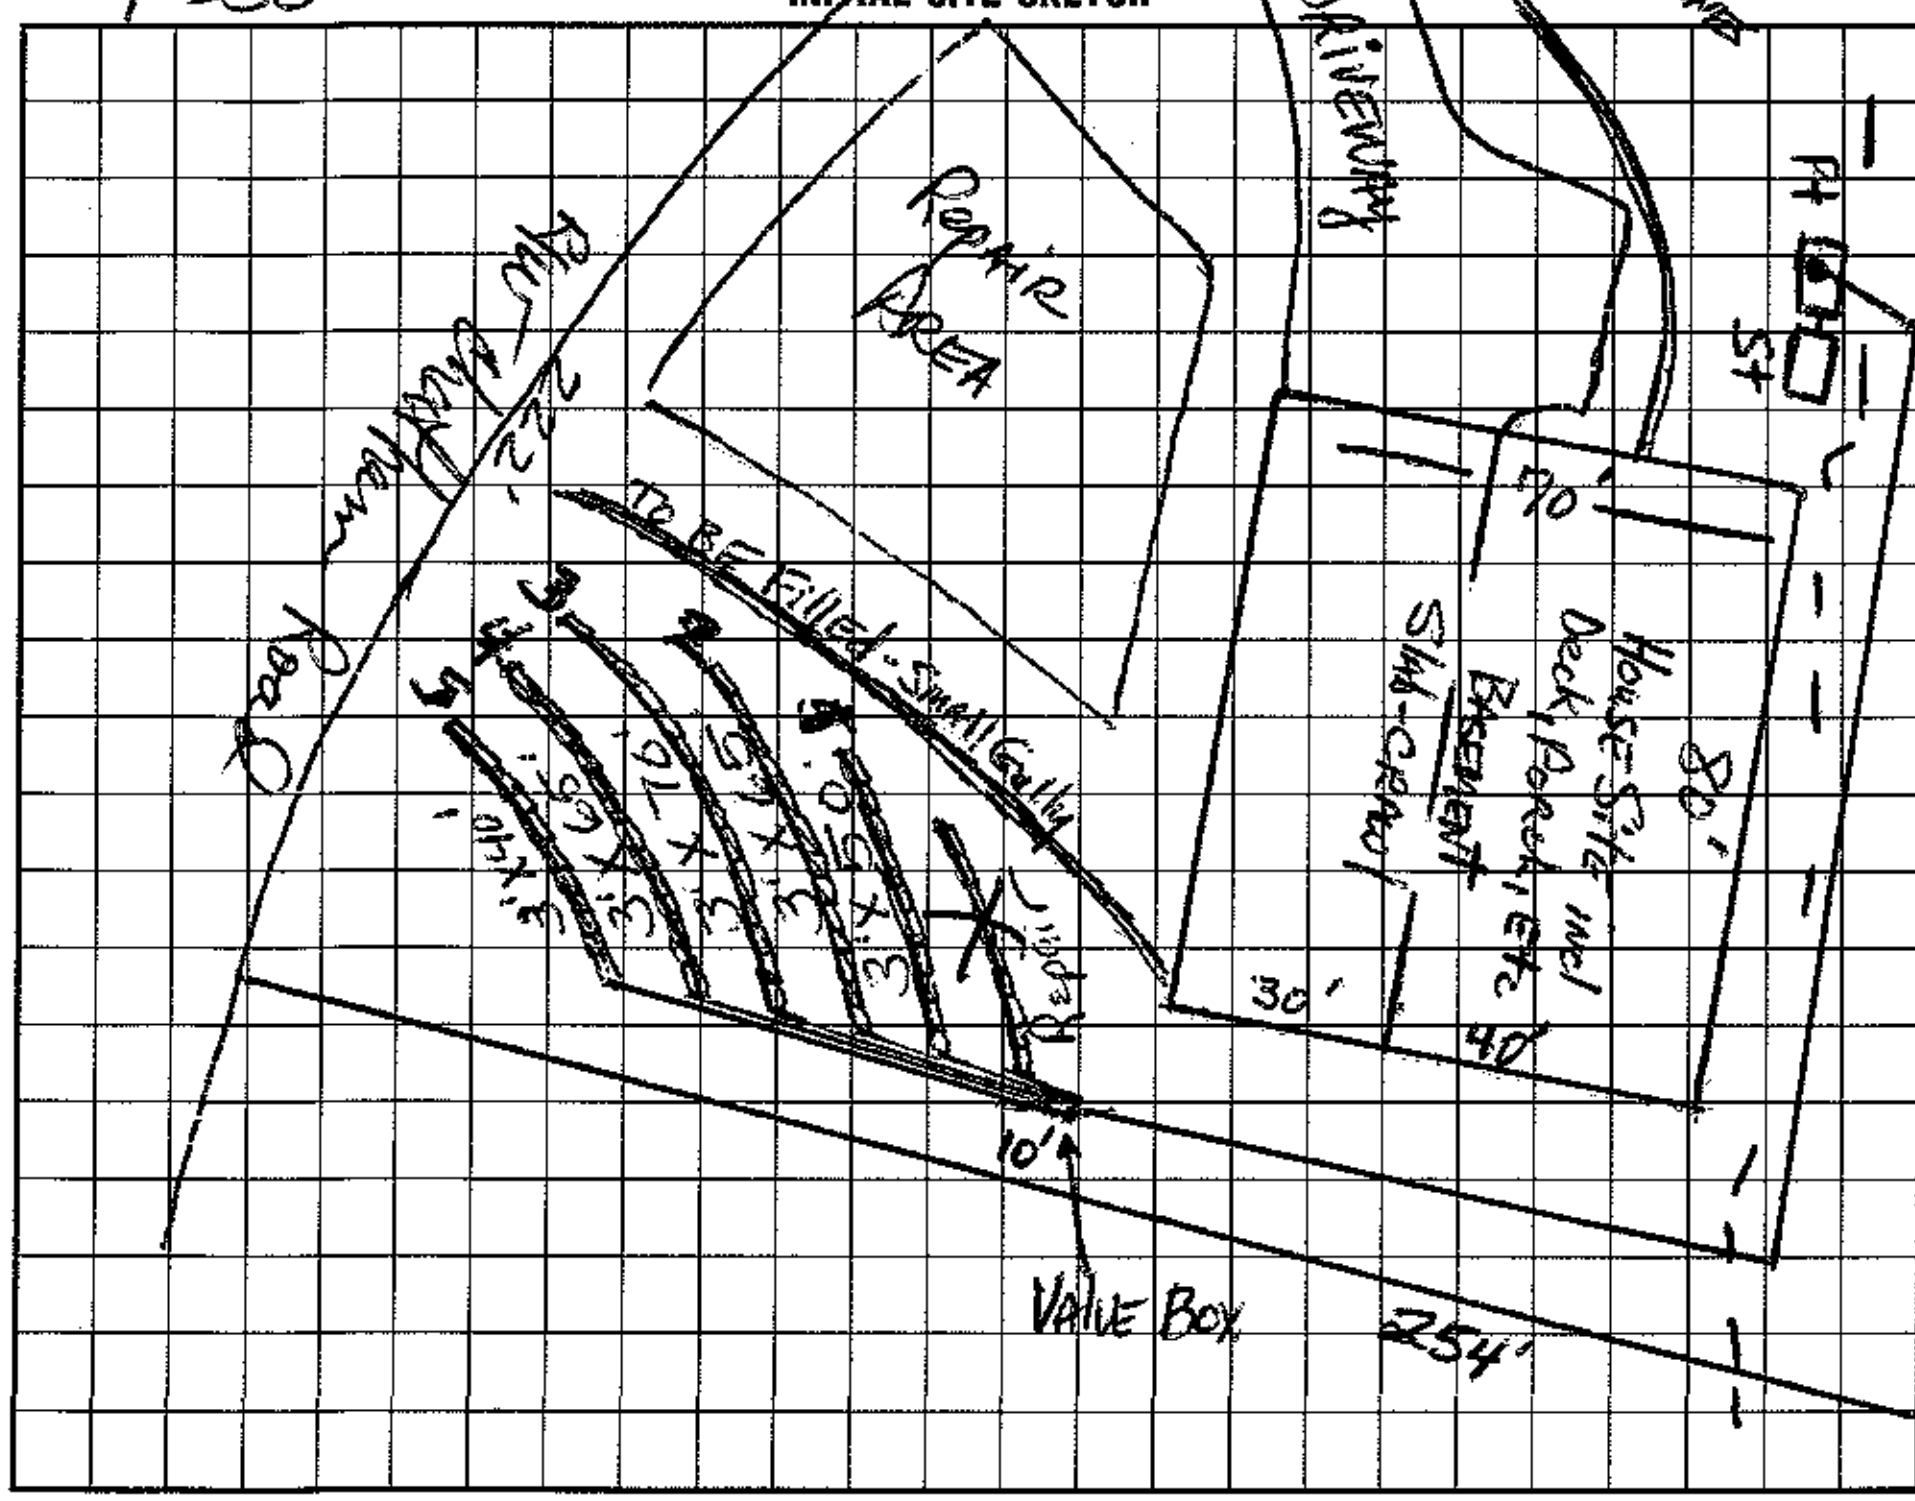

AS BUILT SKETCH

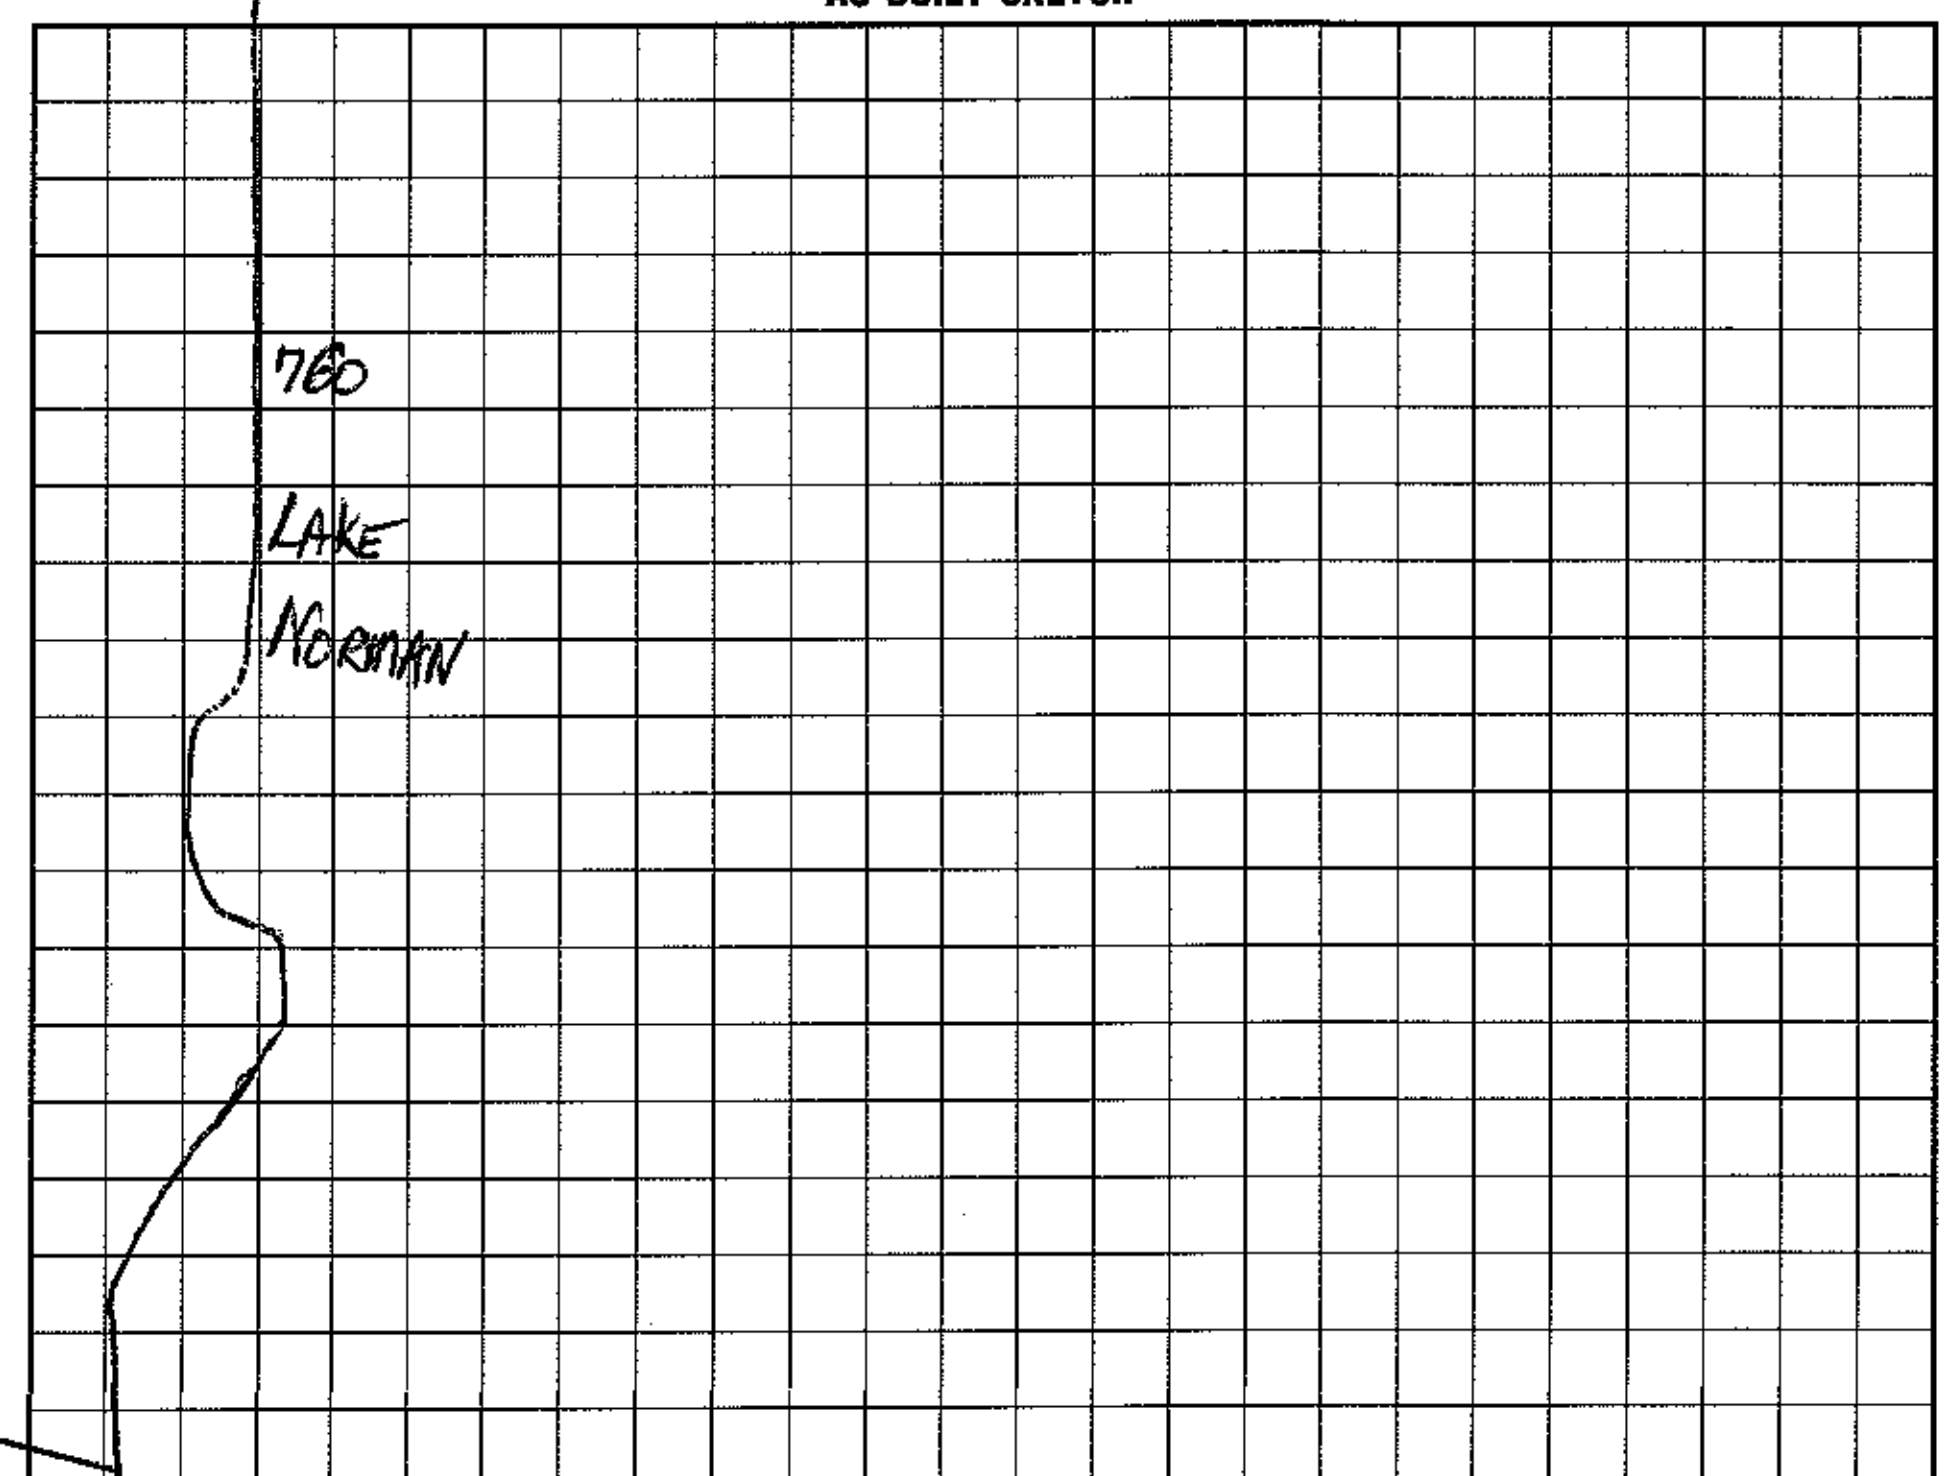

I understand that this permit can be suspended or revoked if any false information is supplied toward securing the permit/any unauthorized changes are made to the site/any unauthorized changes are made in the installation of the system. Improvement Permit with plat valid without expiration. Improvement Permit with site plan valid for sixty months. Authorization to Construct is valid for a period equal to that of Improvement Permit – not to exceed sixty months.

Signed: Tony C [illegible] CPSS (agent) date 10-15-98
Improvement Permit by: [signature] RS date 9-11-98
Authorization to Construct by: [signature] RS date 8-17-99

Installed by: R+H Inc.
Operation Permit by: Wesley Sparks R.S. date 4/8/00
Existing System Inspection by: ______ date ______

HEALTH DEPT. COPY: WHITE INSPECTION COPY (FINAL): GREEN OWNER COPY (FINAL): YELLOW INSPECTION COPY (INITIAL): PINK OWNER COPY (INITIAL): GOLD