IREDELL COUNTY HEALTH DEPARTMENT

STATESVILLE 704-878-5305 MOORESVILLE 704-664-5281

IMPROVEMENT PERMIT / AUTHORIZATION TO CONSTRUCT / OPERATION PERMIT / EXISTING SYSTEM INSPECT

PERMIT# 074965 PIN# 4625941684 4655-06-0720 DATE Nov. 14, '98

OWNER OR CONTRACTOR Crescent Resources Inc. PHONE: Business Home

ADDRESS PO Box 1003 Charlotte

LOCATION Brawley Sch Rd. TL Quaker Rd. immediately on Right

SUBDIVISION The Point BLOCK / SECTION 1-C LOT 2 LOT AREA 73,099 ft² SITE CLASS. PS DESIGN FLOW 480 gpd L.T.A.R. .3

Septic Tank: 1500+ Gallons; STB 338 Date 4-22-00
Pump Tank: 1000 Gallons; PT 283 Date 2-13-00
Pump Make: Model Serial No:
Nitrification Field: No Fields 1 Square Feet 1200 Linear Feet 400
No Lines 4@100' Trench Width 36" Max Trench Bottom Depth 36" Gravel Depth N/A

☑ New System ☐ Repair System Type: I, II, III, IV, V, VI
System Description: pumped - PA - 25% Red. w/ Innovative
Repair System Description: LPP Panel Block
Maintenance Agreement Required: ☐ Yes ☑ No initially

☑ House/Mod. Home No. Bedrooms 4
☐ Mobile Home No. Bathrooms 4
☐ Business No. Employees
☐ Other
☐ Slab ☑ Crawl Space ☐ Basement w/plumbing ☐ Basement wo/plumbing


Water Supply: ☐ Individual ☑ Public ☑ Community

Comments:/Conditions:


Comments:/Conditions: * ONE INSPECTION PORT PER LATERAL
Using "Grinder Pump for basement"
Unlocked tanks & lines

1" = 50'

INITIAL SITE SKETCH

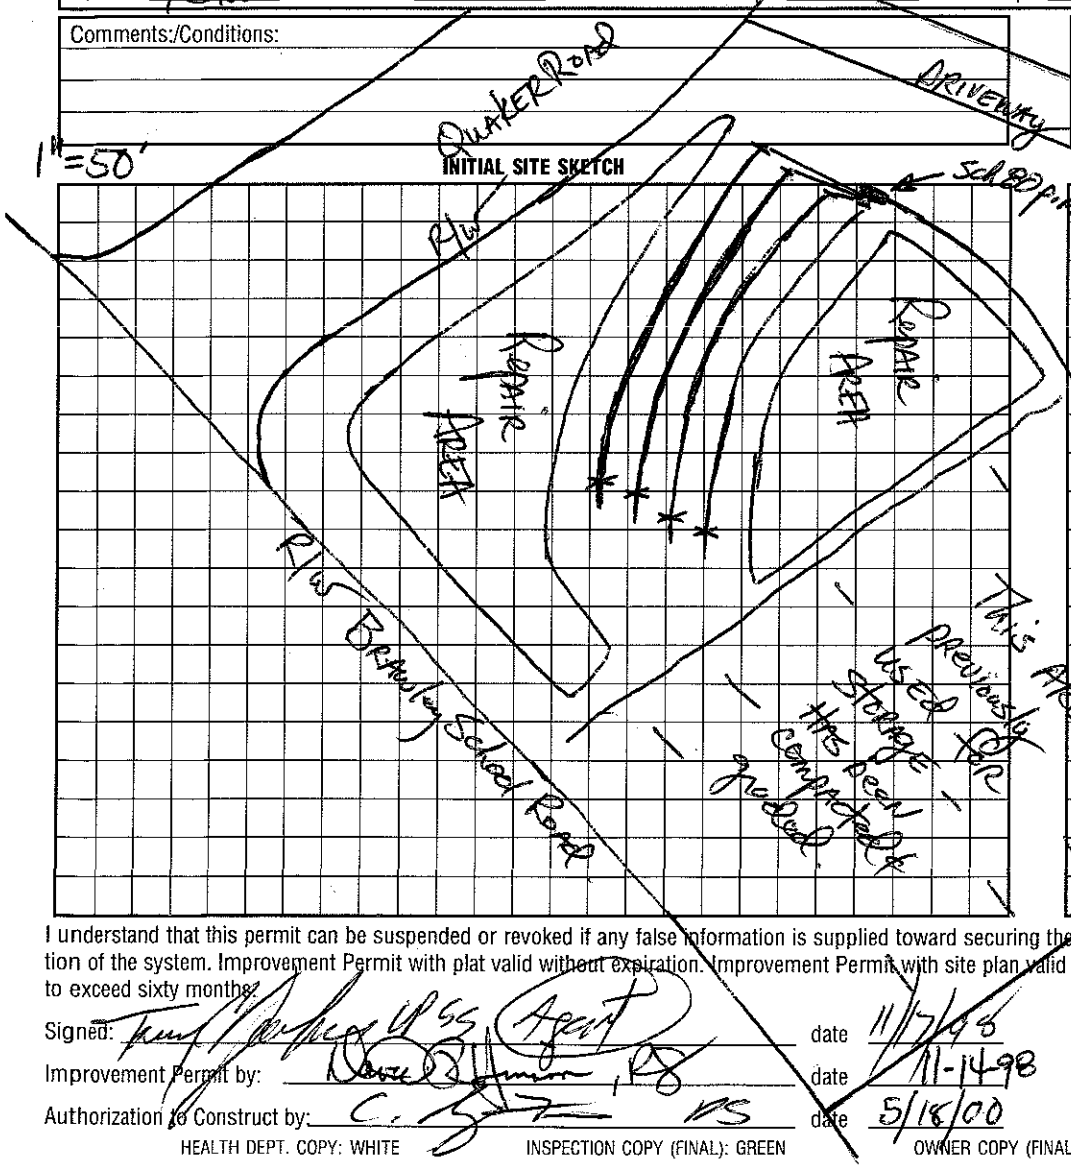

AS BUILT SKETCH

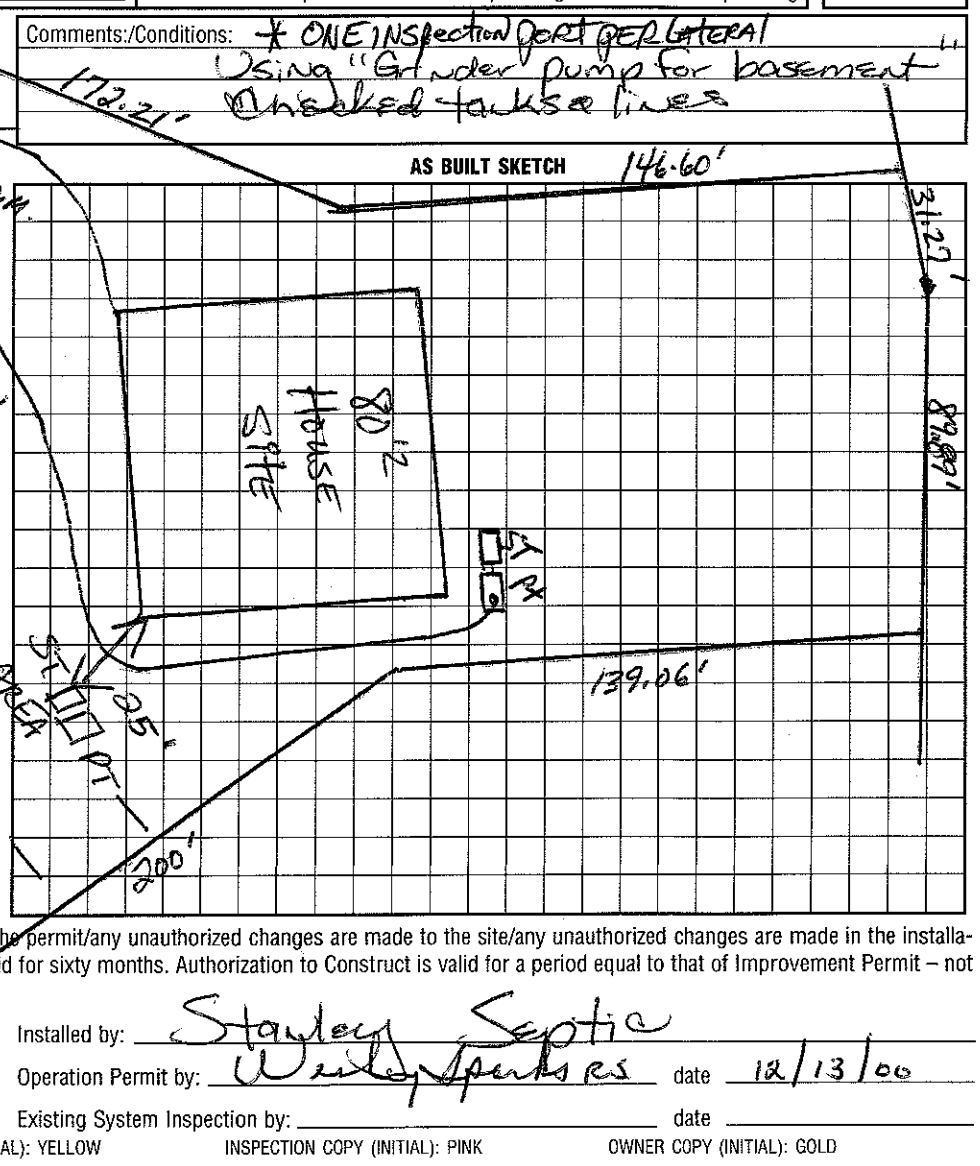

I understand that this permit can be suspended or revoked if any false information is supplied toward securing the permit/any unauthorized changes are made to the site/any unauthorized changes are made in the installation of the system. Improvement Permit with plat valid without expiration. Improvement Permit with site plan valid for sixty months. Authorization to Construct is valid for a period equal to that of Improvement Permit – not to exceed sixty months.

Signed: [signature] LSS Agent date 11/17/98
Improvement Permit by: [signature] RS date 11-14-98
Authorization to Construct by: [signature] RS date 5/18/00

Installed by: Stanley Septic
Operation Permit by: Wesley Sparks RS date 12/13/00
Existing System Inspection by: date

HEALTH DEPT. COPY: WHITE INSPECTION COPY (FINAL): GREEN OWNER COPY (FINAL): YELLOW INSPECTION COPY (INITIAL): PINK OWNER COPY (INITIAL): GOLD