# IREDELL COUNTY HEALTH DEPARTMENT

STATESVILLE 704-878-5305 MOORESVILLE 704-664-5281

## IMPROVEMENT PERMIT / AUTHORIZATION TO CONSTRUCT / OPERATION PERMIT / EXISTING SYSTEM INSPECTION

PERMIT# 074969 PIN# 4625941684 4635-06-2922 DATE Nov 4, 1998

OWNER OR CONTRACTOR Crescent Resources / Lyne Lew Realey PHONE: Business Home

ADDRESS P.O. Box 1003 Charlotte NC PO Box 3398 Mooresville

LOCATION Brawley Sch Rd TL Quaker Road on Right 120 Quaker

SUBDIVISION The Point BLOCK / SECTION 1-C LOT 4, 4A LOT AREA 39834 SFE 130x152 SITE CLASS. 3 (4A) DESIGN FLOW 480gpd L.T.A.R. .3 (4A)

Septic Tank: 1000 t Gallons; STB 8-3-03 Date 338

Pump Tank: 1000 Gallons; PT 8-6-03 Date 27

Pump Make: Model Serial No.

Nitrification Field: No Fields 1 Square Feet 1200 Linear Feet 400

No Lines 4 @ 100' Trench Width 36" Max Trench Bottom Depth 36"

☑ New System ☐ Repair System Type: I, II, (III), IV, V, VI

System Description: pumped-pm 25% Red / Innovative on 4A

Repair System Description: Same

Maintenance Agreement Required: ☐ Yes ☑ No

Gravel Depth N/A

☑ House/Mod. Home ☐ Mobile Home ☐ Business ☐ Other

No. Bedrooms 4/4 No. Bathrooms 4/4 No. Employees

☐ Slab ☑ Crawl Space ☐ Basement w/plumbing ☐ Basement wo/plumbing


Water Supply: ☐ Individual ☑ Public ☑ Community

Comments:/Conditions: None inspection per lateral


Comments:/Conditions: Tanks Checked 9/11/03
Lines checked 9/12/03
Press, elect & alarm 12/9/03 MD
EZ Flow

1"=100'

INITIAL SITE SKETCH

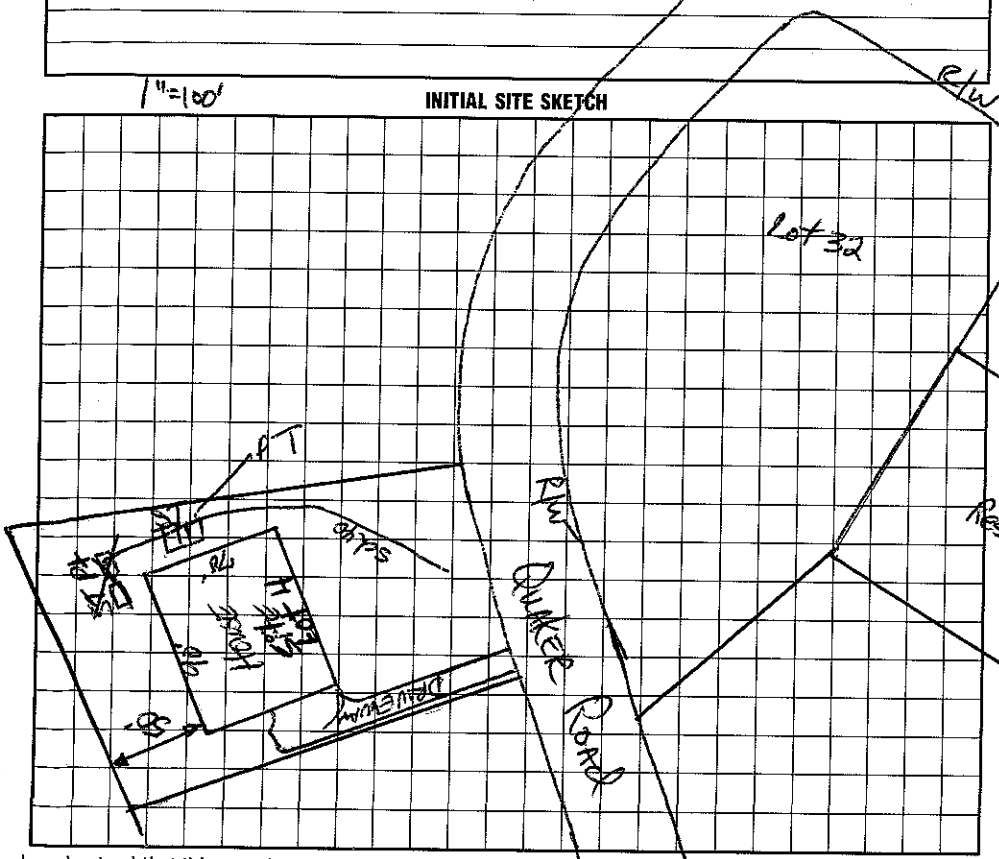


AS BUILT SKETCH

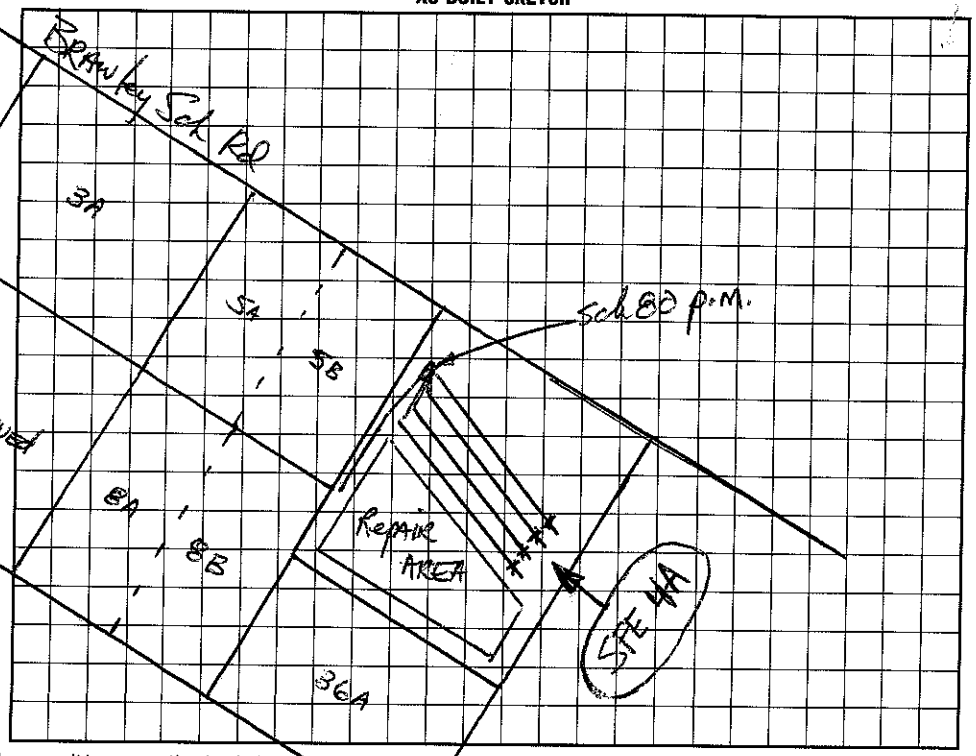


I understand that this permit can be suspended or revoked if any false information is supplied toward securing the permit/any unauthorized changes are made to the site/any unauthorized changes are made in the installation of the system. Improvement Permit with plat valid without expiration. Improvement Permit with site plan valid for sixty months. Authorization to Construct is valid for a period equal to that of Improvement Permit – not to exceed sixty months.

Signed: [signature] date 11/12/98

Improvement Permit by: [signature], RS date 1-4-98

Authorization to Construct by: [signature], RS date 4-30-02

Installed by: R&H Inc RS

Operation Permit by: [signature] date 12/9/03

Existing System Inspection by: date

HEALTH DEPT. COPY: WHITE INSPECTION COPY (FINAL): GREEN OWNER COPY (FINAL): YELLOW INSPECTION COPY (INITIAL): PINK OWNER COPY (INITIAL): GOLD