634-8241 MAYHEW 4:00 pm

IREDELL COUNTY HEALTH DEPARTMENT

SVILLE 704-878-5305 MOORESVILLE 704-664-5281

IMPROVEMENT PERMIT / AUTHORIZATION TO CONSTRUCT / OPERATION PERMIT / EXISTING SYSTEM INSPECTION

PERMIT# 073956 PIN# 4625941684 4635-06-3045 DATE Oct 13, '98

OWNER OR CONTRACTOR Crescent Resources Corp. // Hughes, Hunsucker & Zapple PHONE: Business _____ Home _____

ADDRESS P.O. Box 1003 Charlotte 304-C E. Blvd. Charlotte

LOCATION Brawley Sch. Rd. TL Chatham Rd. TL Mayfair Rd. on left

SUBDIVISION The Point BLOCK / SECTION 1-B LOT 54 LOT AREA 30,875 ft² SITE CLASS. PS DESIGN FLOW 480 gpd L.T.A.R. N.25

Septic Tank: 1500+ Gallons; STB 797 Date 2/94

Pump Tank: 1000 Gallons; PT 27 Date 2/94

Pump Make: MYERS Model ME 585-21 Serial No. 3-99

Nitrification Field: No Fields 1 Square Feet 960 Linear Feet 320

No Lines 4@80' Trench Width 36" Max Trench Bottom Depth ~30" Gravel Depth NA

☑ New System ☐ Repair System Type: I, II, III, (IV), V, VI

System Description: LP Panel Block

Repair System Description: LP Panel Block

Maintenance Agreement Required: ☑ Yes ☐ No

☑ House/Mod. Home No. Bedrooms 4/4

☐ Mobile Home No. Bathrooms 4/4

☐ Business No. Employees ____

☐ Other ____

☐ Slab ☑ Crawl Space ☐ Basement w/plumbing ☐ Basement wo/plumbing


Water Supply: ☐ Individual ☑ Public ☐ Community

Comments:/Conditions: Nov. 16-'98 Site plan Reviewed - House location appears in compliance w/ I.P. Dkft

Comments:/Conditions:

1"=50'

INITIAL SITE SKETCH

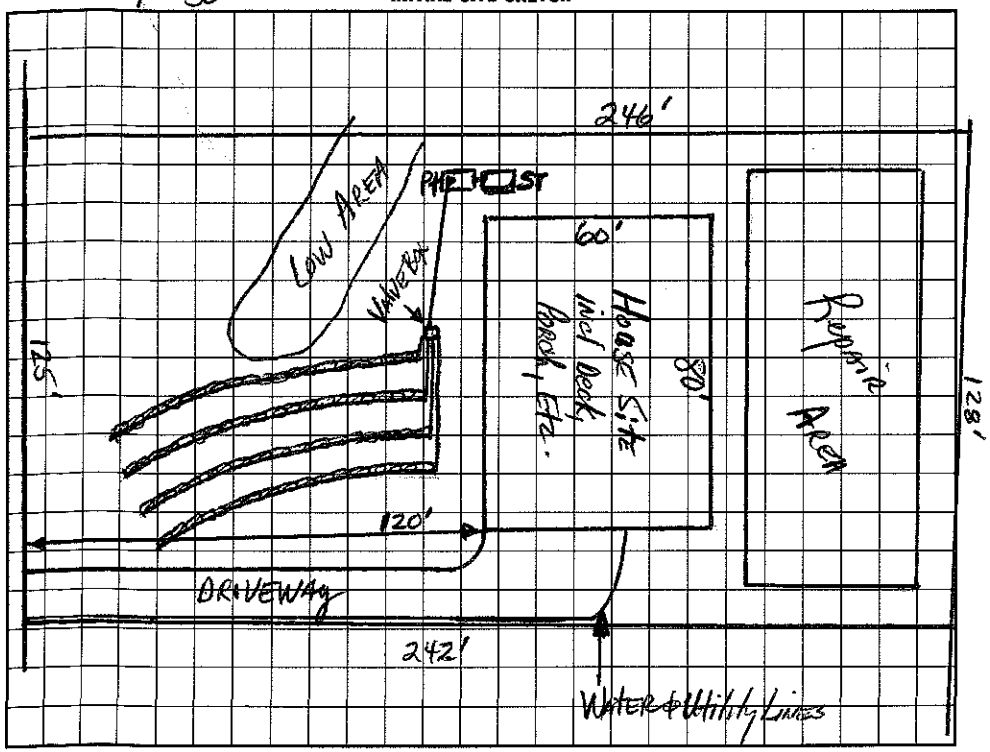

AS BUILT SKETCH

I understand that this permit can be suspended or revoked if any false information is supplied toward securing the permit/any unauthorized changes are made to the site/any unauthorized changes are made in the installation of the system. Improvement Permit with plat valid without expiration. Improvement Permit with site plan valid for sixty months. Authorization to Construct is valid for a period equal to that of Improvement Permit – not to exceed sixty months.

Signed: [signature] Agent date 10/13/98

Improvement Permit by: [signature], RS date 10-13-98

Authorization to Construct by: [signature], RS date 11-16-98

Installed by: Bob Mayhew

Operation Permit by: Wesley Sparks RS. date 7/8/99

Existing System Inspection by: _____ date _____

HEALTH DEPT. COPY: WHITE INSPECTION COPY (FINAL): GREEN OWNER COPY (FINAL): YELLOW INSPECTION COPY (INITIAL): PINK OWNER COPY (INITIAL): GOLD