IREDELL COUNTY HEALTH DEPARTMENT

STATESVILLE 704-878-5305 MOORESVILLE 704-664-5281

IMPROVEMENT PERMIT / AUTHORIZATION TO CONSTRUCT / OPERATION PERMIT / EXISTING SYSTEM INSPECTIO

PERMIT# 0739584 PIN# 4625944684 4635-06-4106 DATE Oct. 13, '98

OWNER OR CONTRACTOR Crescent Resources (Dave Dibble Custom Homes) PHONE: Business _____ Home _____

ADDRESS PO Box 1003, Charlotte

LOCATION Brawley Sch Rd. TL Chatham Rd TL Mayfair Rd. on left

SUBDIVISION The Point BLOCK / SECTION 1-B LOT 53 LOT AREA 30,542 sq ft SITE CLASS. AS DESIGN FLOW 480gpd L.T.A.R. -2-.25

Septic Tank: 1500 Gallons; STB 794 Date 7/4/99
Pump Tank: 1000 Gallons; PT 27 Date 7/3/99
Pump Make: MYERS Model ME-J05ZI Serial No. 59942
Nitrification Field: No Fields 1 Square Feet 1080 Linear Feet 360
No Lines 4@90' Trench Width 36" Trench Bottom Depth 36" Gravel Depth NA

☑ New System ☐ Repair System Type: I, II, III, IV, V, VI
System Description: LP Panel Block
Repair System Description: LP Panel Block
Maintenance Agreement Required: ☑ Yes ☐ No

☑ House/Mod. Home No. Bedrooms 4/4
☐ Mobile Home No. Bathrooms
☐ Business No. Employees
☐ Other

☐ Slab ☑ Crawl Space ☐ Basement w/plumbing ☐ Basement wo/plumbing


Water Supply: ☐ Individual ☑ Public ☐ Community

Comments:/Conditions: Anti-siphon hole required in supply line above pump, Remove any old burning, Tenances.

3-26-99 Reviewed house site plan; appears in compliance w/ I.P.

Comments:/Conditions:

INITIAL SITE SKETCH

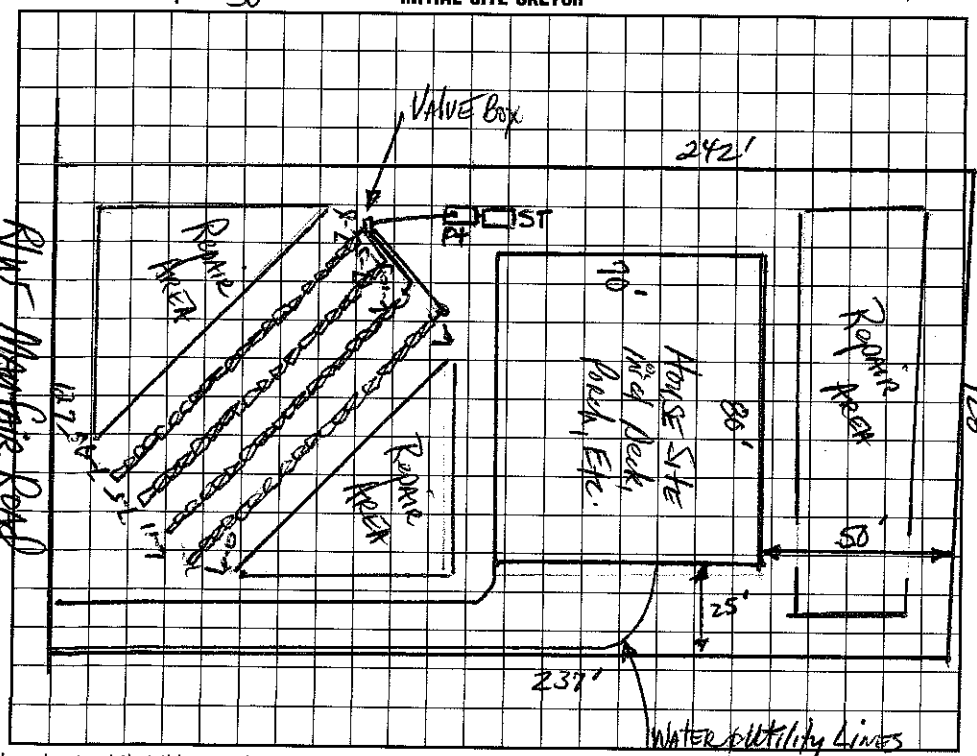

AS BUILT SKETCH

I understand that this permit can be suspended or revoked if any false information is supplied toward securing the permit/any unauthorized changes are made to the site/any unauthorized changes are made in the installation of the system. Improvement Permit with plat valid without expiration. Improvement Permit with site plan valid for sixty months. Authorization to Construct is valid for a period equal to that of Improvement Permit – not to exceed sixty months.

Signed: _____ date 10/15/98

Improvement Permit by: _____ date 10-13-98

Authorization to Construct by: _____ date 3-26-99

Installed by: Dotson

Operation Permit by: Wesley Sparks R.S. date 11/23/99

Existing System Inspection by: _____ date _____

HEALTH DEPT. COPY: WHITE INSPECTION COPY (FINAL): GREEN OWNER COPY (FINAL): YELLOW INSPECTION COPY (INITIAL): PINK OWNER COPY (INITIAL): GOLD