IREDELL COUNTY HEALTH DEPARTMENT

STATESVILLE 704-878-5305 50.00 Paid MOORESVILLE 704-664-5281

IMPROVEMENT PERMIT / AUTHORIZATION TO CONSTRUCT / OPERATION PERMIT / EXISTING SYSTEM INSPECTION

PERMIT# 073951 PIN# ~~4625-94-1684~~ 4635-06-5570 DATE 8/11/04

OWNER OR CONTRACTOR John R Poore PHONE: Business 847-0496 Home

ADDRESS 15090 Independence Point Parkway Matthews, NC 28105

LOCATION 11.00 TL Chatham TL Mayfair on (L) across from Forestdale Loop

SUBDIVISION Point BLOCK / SECTION 1B LOT 50 LOT AREA 26,229 Ft² SITE CLASS. PS DESIGN FLOW 480 L.T.A.R. .25

Septic Tank: 1500 Gallons; STB 338 Date 6/12/05
Pump Tank: 1000 Gallons; PT 283 Date 2/4/05
Pump Make: Goulds Model WE03121M Serial No.
Nitrification Field: No Fields 1 Square Feet 960 Linear Feet 320
No Lines 4 Trench Width 3' Max Trench Bottom Depth ~30" Gravel Depth No

[X] New System [ ] Repair System Type: I, II, III, IV, V, VI
System Description: PressDemd - 16" PPBPS
Repair System Description: Same
Maintenance Agreement Required: [X] Yes [ ] No

[X] House/Mod. Home No. Bedrooms 4
[ ] Mobile Home No. Bathrooms 4
[ ] Business No. Employees
[ ] Other
[X] Slab [X] Crawl Space [ ] Basement w/plumbing [ ] Basement wo/plumbing


Water Supply:
[ ] Individual
[ ] Public
[X] Community
POINT

Comments:/Conditions 8/29/05 Sprinkler heads removed that were in drainfield; water line will be removed per Builder.

Comments:/Conditions: Checked tanks & lines 7/19/05
8/29/05
Risers not high enough; plumbed ~~front to~~ to PT, Sprinklers in Drainfield Corrected.

(1" = 50')

INITIAL SITE SKETCH

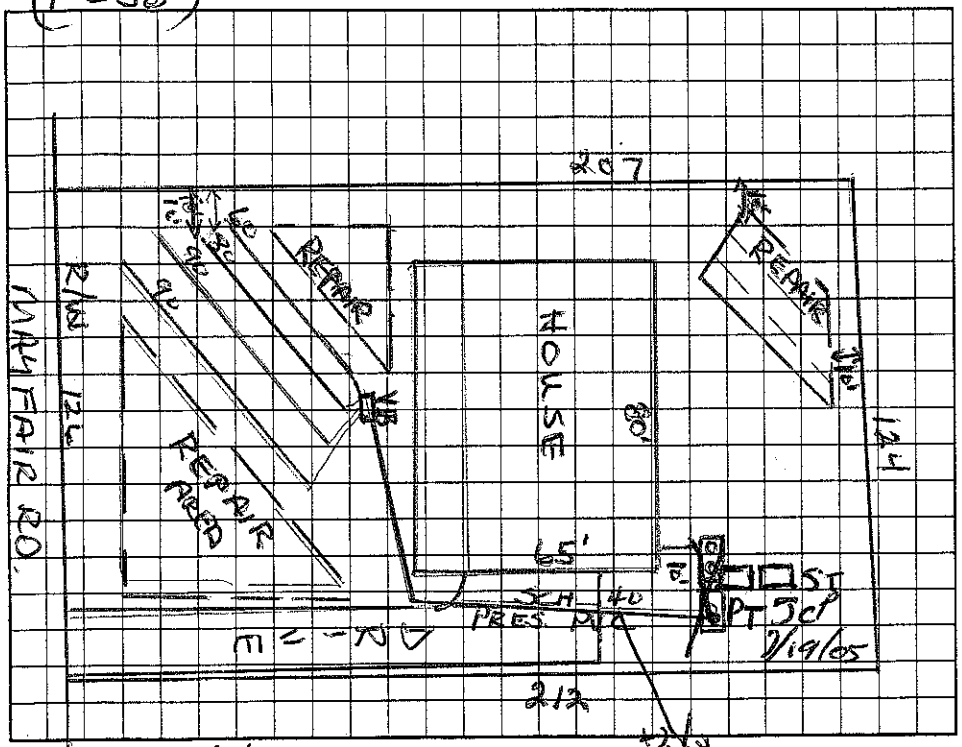

AS BUILT SKETCH

Installed Drainfield as Drawn (Panel Blk)

Permit can be suspended or revoked if any false information is supplied toward securing the permit/any unauthorized changes are made to the site/any unauthorized changes are made in the installation of the system. Improvement Permit with plat valid without expiration. Improvement Permit with site plan valid for sixty months. Authorization to Construct is valid for a period equal to that of Improvement Permit – not to exceed sixty months.

Signed: John Poore date 8/12/04
Improvement Permit by: Wesley Sparks R.S. date 8/11/04
Authorization to Construct by: Wesley Sparks R.S. date 8/11/04

Installed by: R & H Dolson R.S.
Operation Permit by: Mark H Dolson date 8/29/05
Existing System Inspection by: date

HEALTH DEPT. COPY: WHITE OWNER COPY (FINAL): YELLOW OWNER COPY (INITIAL): PINK