IREDELL COUNTY HEALTH DEPARTMENT

STATESVILLE 704-878-5305 MOORESVILLE 704-664-5281

IMPROVEMENT PERMIT / AUTHORIZATION TO CONSTRUCT / OPERATION PERMIT / EXISTING SYSTEM INSPECTION

PERMIT# 072880 PIN# 4625946084 (pt) 4635-06-6038 DATE Sept. 12, '98

OWNER OR CONTRACTOR Crescent Resources Const. PHONE: Business Home

ADDRESS P.O. Box 1003, Charlotte

LOCATION Blakley Church Rd. TL Matheson Rd. TL Mayfield on Right

SUBDIVISION The Point BLOCK / SECTION I-B LOT 19 LOT AREA 24,076 sf± SITE CLASS PS DESIGN FLOW 480gpd L.T.A.R. 1.3

Septic Tank: ~~1000~~ 1500 Gallons; STB 797 Date 1/11/99

Pump Tank: 1000 Gallons; PT 27 Date 2/12/99

Pump Make: MYERS Model ME 50 S2 Serial No 8-98

Nitrification Field: No Fields ____ Square Feet 900 Linear Feet 300

No Lines 4 Trench Width 36" Max Trench Bottom Depth 30" Gravel Depth N/A

☑ New System ☐ Repair System Type: I, II, III, IV, V, VI

System Description: LP Panel Block

Repair System Description: SAME

Maintenance Agreement Required: ☑ Yes ☐ No

☑ House/Mod. Home No. Bedrooms 4

☐ Mobile Home No. Bathrooms 4

☐ Business No. Employees ____

☐ Other ____

☑ Slab ☑ Crawl Space ☐ Basement w/plumbing ☐ Basement wo/plumbing

Water Supply: ☐ Individual ☐ ~~Public~~ ☐ Community


Comments/Conditions:

Comments/Conditions:

66
3.6
3.6
198
733.6

1"=50'

INITIAL SITE SKETCH

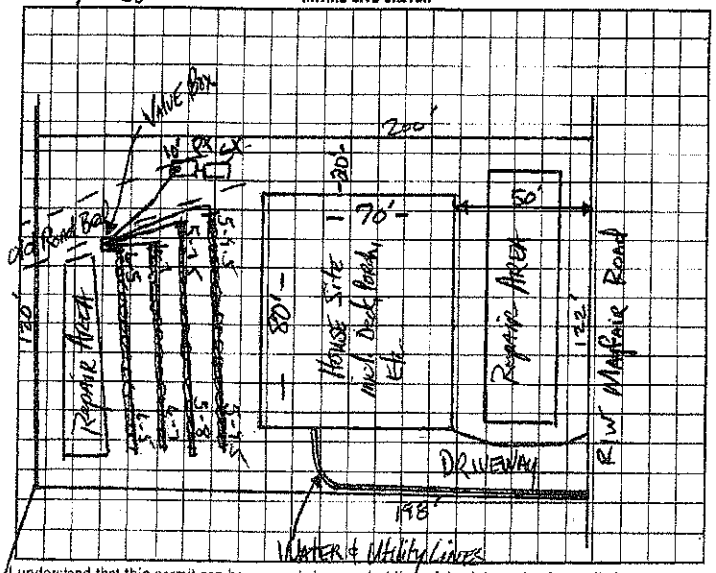

AS BUILT SKETCH

The proposed / existing Patio addition does not appear to impact the existing septic system.

**NOTE: Patio w/in 70' house box

Judy Melville R.S.

Date: 5-17-12

ICHD-Environmental Health Division

I understand that this permit can be suspended or revoked if any false information is supplied toward securing the permit/any unauthorized changes are made to the site/any unauthorized changes are made in the installation of the system. Improvement Permit with plat valid without expiration. Improvement Permit with site plan valid for sixty months. Authorization to Construct is valid for a period equal to that of Improvement Permit – not to exceed sixty months.

Signed: (Agent) date 10/[illegible]/98

Improvement Permit by: Mark S. Hamm, RS date 9-12-98

Authorization to Construct by: RS date 1/5/99

Installed by: R & H Inc.

Operation Permit by: Jeff Myers date 8/1/99

Existing System Inspection by: ____ date ____

HEALTH DEPT. COPY: WHITE INSPECTION COPY (FINAL): GREEN OWNER COPY (FINAL): YELLOW INSPECTION COPY (INITIAL): PINK OWNER COPY (INITIAL): GOLD