IREDELL COUNTY HEALTH DEPARTMENT

STATESVILLE 704-878-5305 MOORESVILLE 704-664-5[illegible]

IMPROVEMENT PERMIT / AUTHORIZATION TO CONSTRUCT / OPERATION PERMIT / EXISTING SYSTEM INSPE[illegible]

PERMIT# 07388O PIN# ~~4625446604~~ (Ms) 4635 06 6038 DATE Sept. 12, 198[illegible]

OWNER OR CONTRACTOR Crescent Resources Inc. PHONE: Business _____ Home _____

ADDRESS P.O. Box 1003 Charlotte

LOCATION Brawley Sch Rd. TL Rothem Rd. TL Mayfairdale on Right

SUBDIVISION The Pointe BLOCK / SECTION 1-B LOT 19 LOT AREA 24,076 sf SITE CLASS. PS DESIGN FLOW 480gpd L.T.A.R. n.3

Septic Tank: ~~1000~~ 500 Gallons; STB 797 Date 1/11/99

Pump Tank: 1000 Gallons; PT 27 Date 2/12/99

Pump Make: MYERS Model ME 50 S21 Serial No. 8-98

Nitrification Field: No Fields ____ Square Feet 900 Linear Feet 300

No Lines 4 Trench Width 36" Max Trench Bottom Depth 30"

☑ New System ☐ Repair System Type: I, II, III, IV, V, VI

System Description: LP Panel Block

Repair System Description: SAME

Maintenance Agreement Required: ☑ Yes ☐ No

Gravel Depth N/A ☑ Slab ☑ Crawl Space ☐ Basement w/plumbing ☐ Basement wo/plumbing

☑ House/Mod. Home No. Bedrooms 4

☐ Mobile Home No. Bathrooms 4

☐ Business No. Employees ____

☐ Other ____

Water Supply: ☐ Individual ☑ ~~Public~~ ☑ ~~Community~~


Comments:/Conditions:

Comments:/Conditions:

66
3.6
39.6
199
237.6

1"=50'

INITIAL SITE SKETCH

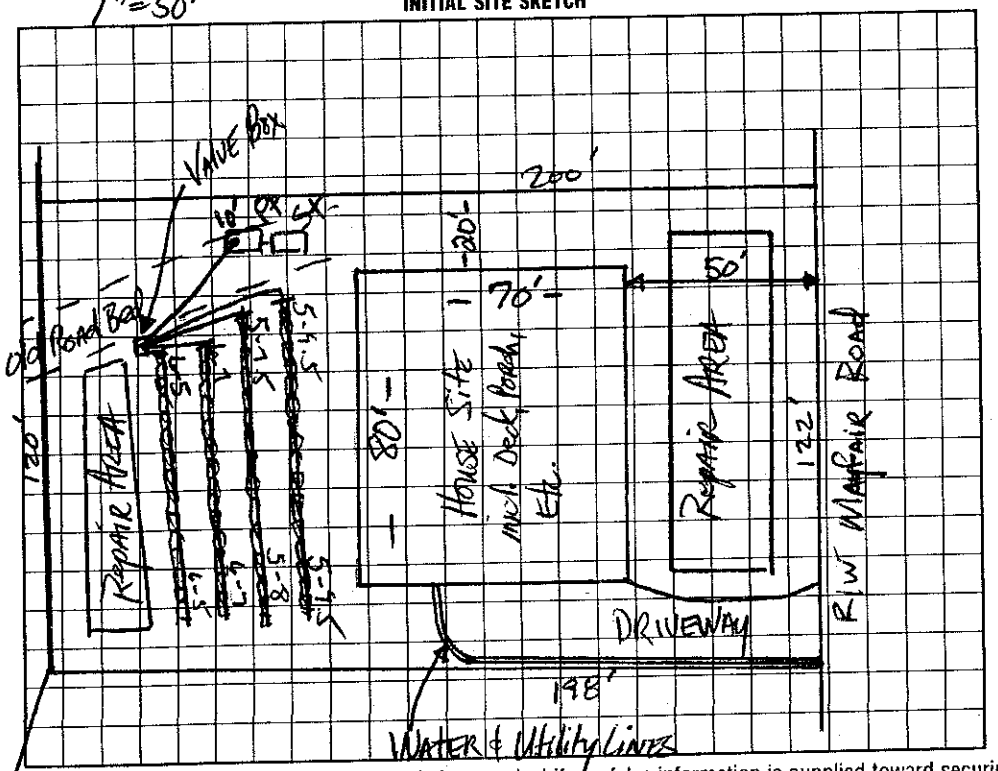

AS BUILT SKETCH

I understand that this permit can be suspended or revoked if any false information is supplied toward securing the permit/any unauthorized changes are made to the site/any unauthorized changes are made in the installation of the system. Improvement Permit with plat valid without expiration. Improvement Permit with site plan valid for sixty months. Authorization to Construct is valid for a period equal to that of Improvement Permit – not to exceed sixty months.

Signed: [signature] (Agent) date 10/29/98

Improvement Permit by: [signature], RS date 9-2-98

Authorization to Construct by: [signature], RS date 11/5/99

Installed by: R & H Inc.

Operation Permit by: Jeff Mozon date 8/11/99

Existing System Inspection by: _____ date _____

INSPECTION COPY (INITIAL): PINK OWNER COPY (INITIAL): GOLD