IREDELL COUNTY HEALTH DEPARTMENT

STATESVILLE 704-878-5305 MOORESVILLE 704-664-5281

IMPROVEMENT PERMIT / AUTHORIZATION TO CONSTRUCT / OPERATION PERMIT / EXISTING SYSTEM INSPECTION

PERMIT# 073881 PIN# 4625941684 4635-06-6280 DATE Feb. 26, '99

OWNER OR CONTRACTOR Crescent Resources Inc. // Simonini Bld. PHONE: Business Home

ADDRESS

LOCATION Brawley Sch Rd. TL Chatham Rd. TL Mayfair Rd. on Right

SUBDIVISION The Point BLOCK / SECTION 1-B LOT 20 LOT AREA 33,192 sf SITE CLASS. A5 DESIGN FLOW 600gpd L.T.A.R. .3

Septic Tank: 1500 Gallons; STB 799 Date 7/9/99
Pump Tank: Gallons; PT Date
Pump Make: Model Serial No.
Nitrification Field: No Fields 1 Square Feet 1500 Linear Feet 500
No Lines 5@100' Trench Width 36" Max Trench Bottom Depth 32" Gravel Depth NA

☑ New System ☐ Repair System Type: I, II, III, IV, V, VI
System Description: Gravity 25% Red. // Innovative LP Panel Block
Repair System Description:
Maintenance Agreement Required: ☐ Yes ☑ No


☑ House/Mod. Home No. Bedrooms 5
☐ Mobile Home No. Bathrooms 5
☐ Business No. Employees
☐ Other
☑ Slab ☑ Crawl Space ☐ Basement w/plumbing ☐ Basement wo/plumbing

Water Supply: ☐ Individual ☑ Public ☑ Community

Comments:/Conditions: * ONE Inspection port per LATERAL.

Comments:/Conditions:

INITIAL SITE SKETCH 1"=50'

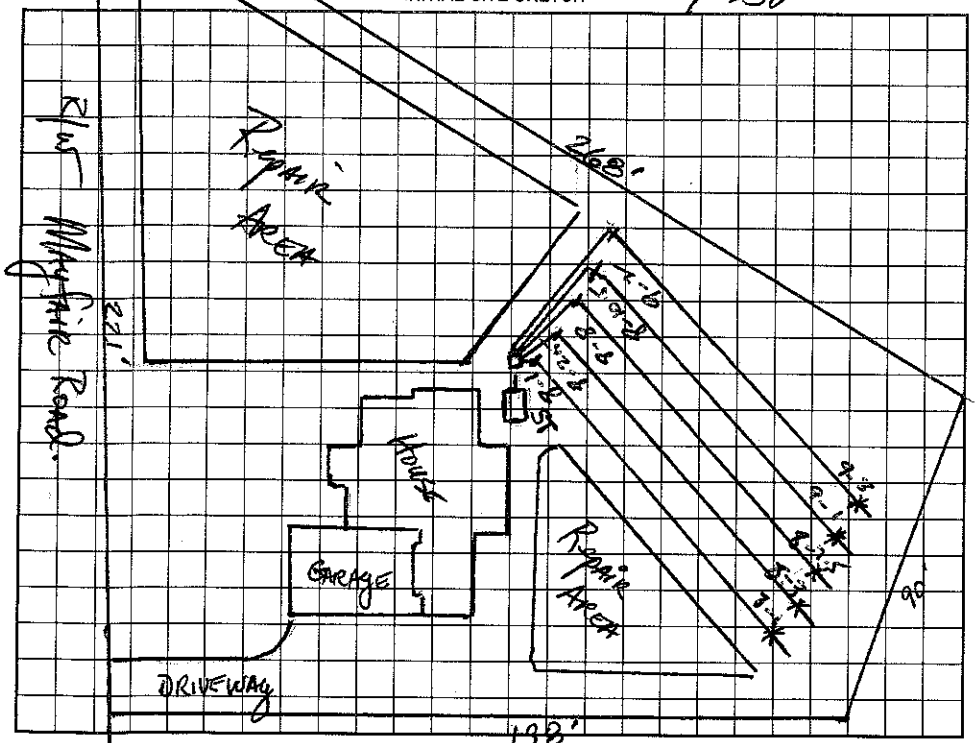

AS BUILT SKETCH

Permit can be suspended or revoked if any false information is supplied toward securing the permit/any unauthorized changes are made to the site/any unauthorized changes are made in the installation of the system. Improvement Permit with plat valid without expiration. Improvement Permit with site plan valid for sixty months. Authorization to Construct is valid for a period equal to that of Improvement Permit – not to exceed sixty months.

Signed: date 3/1/99 Installed by: H+R Const.

Improvement Permit by: IRS date 2-26-99 Operation Permit by: Wesley Sparks RS. date 9/20/99

Authorization to Construct by: IRS date 2-26-99 Existing System Inspection by: date

HEALTH DEPT. COPY: WHITE OWNER COPY (FINAL): YELLOW OWNER COPY (INITIAL): PINK