2.30

IREDELL COUNTY HEALTH DEPARTMENT

STATESVILLE 704-878-5305 MOORESVILLE 704-664-5281

IMPROVEMENT PERMIT / AUTHORIZATION TO CONSTRUCT / OPERATION PERMIT / EXISTING SYSTEM INSPECTION

PERMIT# 073949 PIN# 4625946894 4635-06-6773 DATE Sept. 22 98

OWNER OR CONTRACTOR Crescent Resources Inc. // Hughes & Assoc. PHONE: Business Home

ADDRESS P.O. Box 1003, Charlotte

LOCATION Brawley Sch. Rd. Tl Chatham Rd Tl Mayfair Rd. on left across from Forestdale Loop

SUBDIVISION The Point BLOCK / SECTION 1-B LOT 48 LOT AREA 30,792 ft SITE CLASS. RS DESIGN FLOW 480 gpd L.T.A.R. 1 or 3

Septic Tank: 1000 + Gallons; STB 797 Date 5/7/98

Pump Tank: Gallons; PT Date

Pump Make: Model Serial No.

Nitrification Field: No Fields 1 Square Feet 1200 Linear Feet 400

No Lines 5 @ 80' Trench Width 36" Max Trench Bottom Depth 36" Gravel Depth N/A

☑ New System ☐ Repair System Type: I, II, (III) IV, V, VI

System Description: Gravity 25% Reduction

Repair System Description: Low Pressure Pipe

Maintenance Agreement Required: ☐ Yes ☑ No

☑ House/Mod. Home ☐ Mobile Home ☐ Business ☐ Other

No. Bedrooms 4 No. Bathrooms 4 No. Employees

☑ Slab ☑ Crawl Space ☐ Basement w/plumbing ☐ Basement wo/plumbing


Water Supply: ☐ Individual ☑ Public ☑ Community

Comments:/Conditions: * ONE Inspection port per Lateral.

Jan 5, '99 House & Site plan reviewed — Appears in compliance w/ EPOOK

Comments:/Conditions:

INITIAL SITE SKETCH

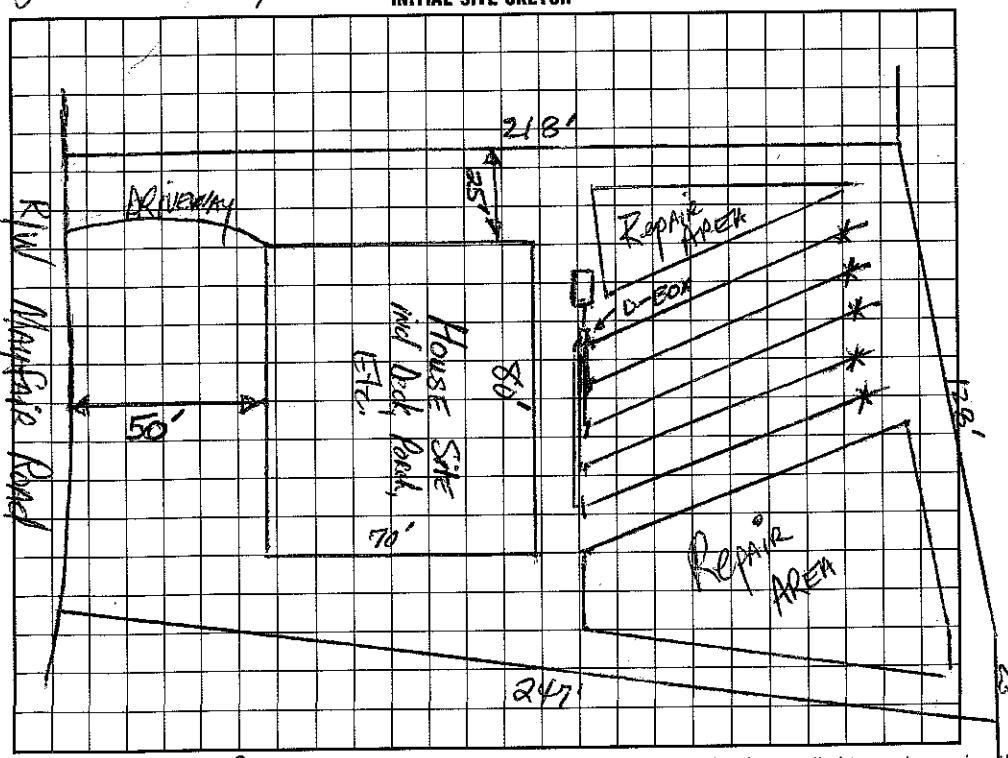

AS BUILT SKETCH

I understand that this permit can be suspended or revoked if any false information is supplied toward securing the permit/any unauthorized changes are made to the site/any unauthorized changes are made in the installation of the system. Improvement Permit with plat valid without expiration. Improvement Permit with site plan valid for sixty months. Authorization to Construct is valid for a period equal to that of Improvement Permit – not to exceed sixty months.

Signed: date 10/15/98

Improvement Permit by: RS date 9-22-98

Authorization to Construct by: RS date 1-5-99

Installed by: CARLS BIEDRICK

Operation Permit by: RS date 7/28/99

Existing System Inspection by: date

HEALTH DEPT. COPY: WHITE INSPECTION COPY (FINAL): GREEN OWNER COPY (FINAL): YELLOW INSPECTION COPY (INITIAL): PINK OWNER COPY (INITIAL): GOLD