IREDELL COUNTY HEALTH DEPARTMENT

STATESVILLE 704-878-5305 MOORESVILLE 704-664-5281

IMPROVEMENT PERMIT / AUTHORIZATION TO CONSTRUCT / OPERATION PERMIT / EXISTING SYSTEM INSPECTIO

PERMIT# 123988 PIN# 4635067868 7660-5429 DATE 8-2-07

OWNER OR APPLICANT Zande Homes/Paul Crandall PHONE: Business ~~375-5999~~ Home

ADDRESS 909 East Blvd Charlotte, NC 28203

LOCATION Brawley School Rd TL ~~Mayfair on left~~ Chatham TL Mayfair on left

SUBDIVISION The Point BLOCK / SECTION 1-B LOT 47 LOT AREA 59,131 Ft² SITE CLASS. PS DESIGN FLOW 600 L.T.A.R. .03

Septic Tank: 1500 Gallons: STB 338 Date 5-8-07

Pump Tank: 1500 Gallons: PT 477 Date 5-1-07

Pump Make: Gould's/ITT ~~WE05X1111~~ Serial No. WE1012

Nitrification Field: No Fields 1 Square Feet 1050 Linear Feet 350

No Lines 6 Trench Width 36" Max Trench Bottom Depth 36" Gravel Depth N/A

☒ New System ☐ Repair ☐ Expansion System Type: I II III IV V VI

System Description: LL-Panel Block

Repair System Description: Same

Maintenance Agreement Required: ☒ Yes ☐ No

☒ House/Mod. Home ☐ Mobile Home ☐ Business ☐ Other

No. Bedrooms 5 No. Persons ___ No. Employees ___


Water Supply: ☐ Individual ☐ Public ☒ Community

☐ Gravity ☒ Pressure ☐ Slab ☐ Crawl Space ☒ Basement w/plumbing ☐ Basement wo/plumbing

Comments:/Conditions: 1:60

Scale: 1:60

INITIAL SITE SKETCH

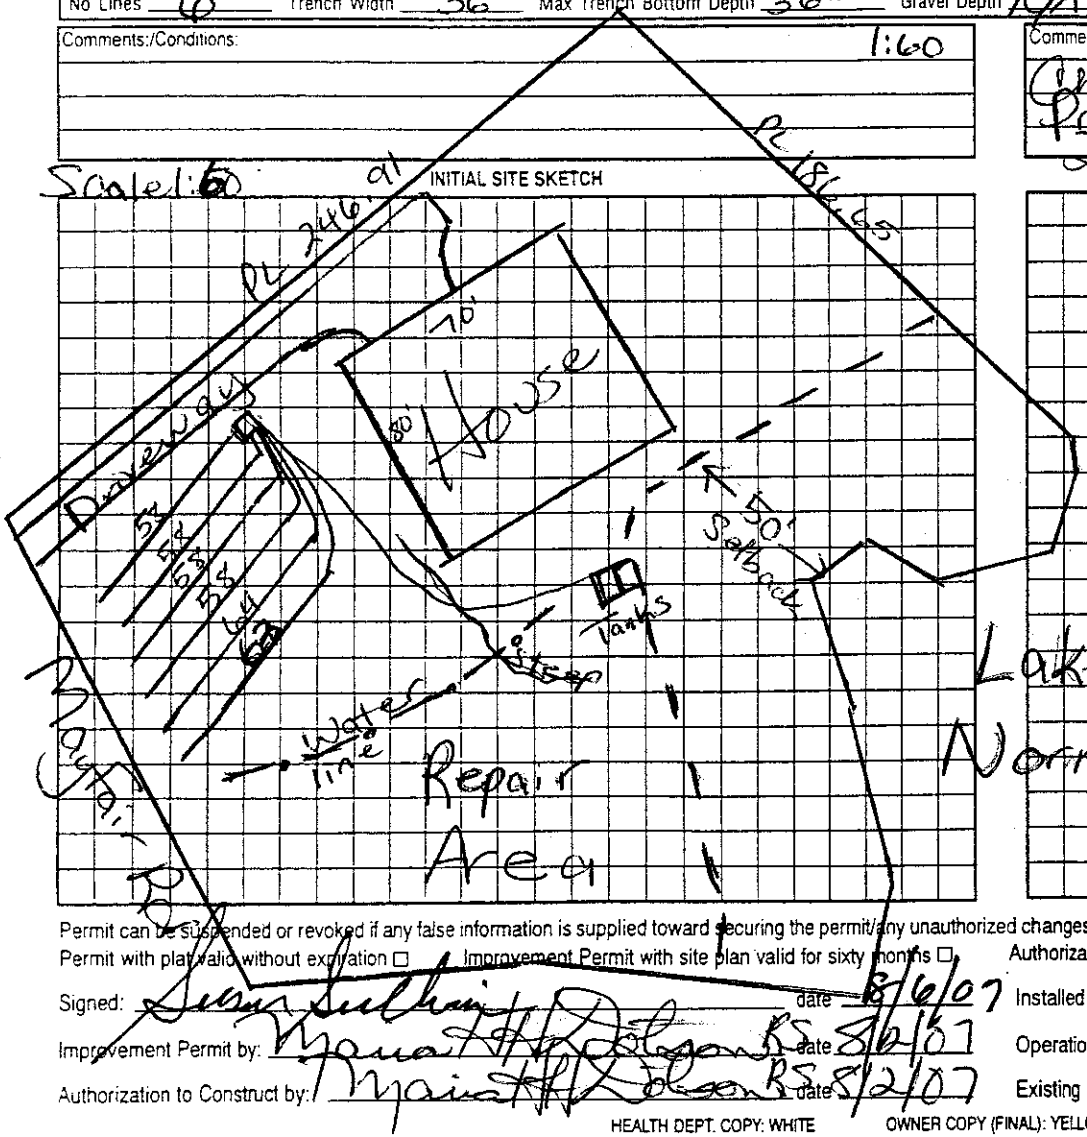

Comments:/Conditions: Checked Tanks 6/8/07
Checked lines 8/8/07
Press. elect. alarm set
OFF pressure. 3/16" hole 10/2/07
(Had to chg pump

AS BUILT SKETCH

The proposed / existing Finishing Basement addition does not appear to impact the existing septic system.
**NOTE Septic System was designed for Future Bedroom in Basement
Maria H. Dolan R.S.
Date: 12/15/07
ICHD-Environmental Health Division

Permit can be suspended or revoked if any false information is supplied toward securing the permit/any unauthorized changes are made to the site/any unauthorized changes are made in the installation of the system. Improvement Permit with plat valid without expiration ☐ Improvement Permit with site plan valid for sixty months ☐ Authorization to Construct is valid for a period equal to that of Improvement Permit – not to exceed sixty months.

Signed: [signature] date 8/6/07

Improvement Permit by: Maria H. Dolan RS date 8/6/07

Authorization to Construct by: Maria H. Dolan RS date 8/2/07

Installed by: R&F date

Operation Permit by: Maria H. Dolan RS date 10/2/07

Existing System Inspection by: ___ date ___

HEALTH DEPT. COPY: WHITE OWNER COPY (FINAL): YELLOW OWNER COPY (INITIAL): PINK