IREDELL COUNTY HEALTH DEPARTMENT

STATESVILLE 704-878-5305 MOORESVILLE 704-664-5281

IMPROVEMENT PERMIT / AUTHORIZATION TO CONSTRUCT / OPERATION PERMIT / EXISTING SYSTEM INSPECTION

PERMIT# 073873 PIN# 4625941684 (pt.) 4635-06-8072 DATE Sept. 12, 198

OWNER OR CONTRACTOR Crescent Resources Inc. / Bill Helms Const PHONE: Business _____ Home _____

ADDRESS P.O. Box 1073 Charlotte

LOCATION Brawley Sch. Rd. TL Chatham Rd. TL Kingsbury Ct. AT END

SUBDIVISION The Pointe BLOCK / SECTION 1-B LOT 13 LOT AREA 35,877 sq ft SITE CLASS. PS DESIGN FLOW 480 gpd L.T.A.R. .3

Septic Tank: ~~1000~~ 1500 Gallons; STB 797 Date 7/5/99

Pump Tank: 1000 Gallons; PT 21 Date 9/26/99

Pump Make: _____ Model _____ Serial No. _____

Nitrification Field: No Fields 1 Square Feet 1200 Linear Feet 400

No Lines 3@134' Trench Width 36" Max Trench Bottom Depth 36" Gravel Depth NA

☑ New System ☐ Repair System Type: I, II, III, IV, V, VI

System Description: pumped-pm-25% Reduction

Repair System Description: LP Panel Block

Maintenance Agreement Required: ☐ Yes ☑ No

☑ House/Mod. Home No. Bedrooms 4

☐ Mobile Home No. Bathrooms 4

☐ Business No. Employees _____

☐ Other _____

☐ Slab ☑ Crawl Space ☐ Basement w/plumbing ☐ Basement wo/plumbing


Water Supply: ☐ Individual ☑ Public ☑ Community

Comments/Conditions: Remove old bulding terraces. sch 80 pm

* ONE INSPECTION PORT PER LATERAL

INITIAL SITE SKETCH


1"=50'

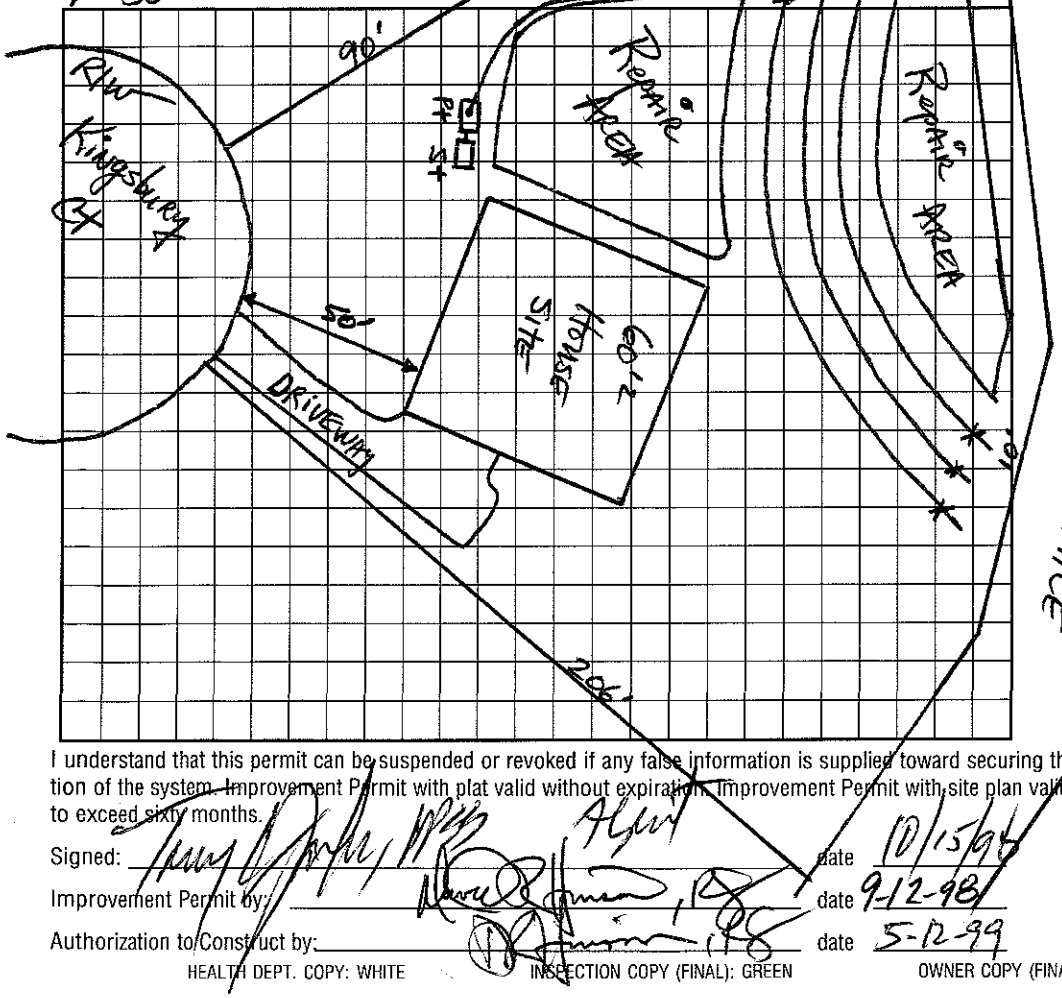

Comments/Conditions: 5-12-99 Reversed house & site plans — Appear in compliance w/ I.P. JRH

EZ-LAY

AS BUILT SKETCH

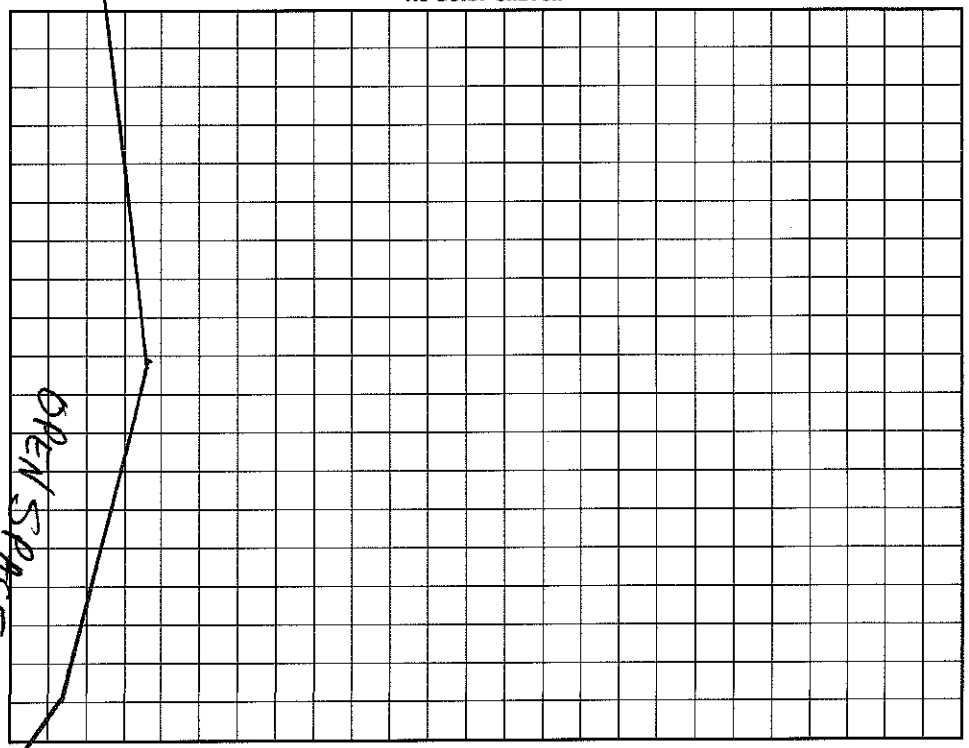

I understand that this permit can be suspended or revoked if any false information is supplied toward securing the permit/any unauthorized changes are made to the site/any unauthorized changes are made in the installation of the system. Improvement Permit with plat valid without expiration. Improvement Permit with site plan valid for sixty months. Authorization to Construct is valid for a period equal to that of Improvement Permit – not to exceed sixty months.

Signed: _____ date 10/15/98

Improvement Permit by: _____ date 9-12-98

Authorization to Construct by: _____ date 5-12-99

Installed by: R + H Inc

Operation Permit by: Wesley Sparks RS. date 1/11/00

Existing System Inspection by: _____ date _____

HEALTH DEPT. COPY: WHITE INSPECTION COPY (FINAL): GREEN OWNER COPY (FINAL): YELLOW INSPECTION COPY (INITIAL): PINK OWNER COPY (INITIAL): GOLD