IREDELL COUNTY HEALTH DEPARTMENT

STATESVILLE 704-878-5305 MOORESVILLE 704-664-5281

IMPROVEMENT PERMIT / AUTHORIZATION TO CONSTRUCT / OPERATION PERMIT / EXISTING SYSTEM INSPECTION

PERMIT# 073883 PIN# 4625941684 4635-06-9372 DATE Sept. 14, '98

OWNER OR CONTRACTOR Crescent Resources LLC - If Permit Dibble Custom Homes PHONE: Business _____ Home _____

ADDRESS P.O. Box 1003, Charlotte

LOCATION Brawley Sch. Rd. TL Chatham Rd. TL Mayfair Rd. TR Forestdale Loop on Right

SUBDIVISION The Pointe BLOCK / SECTION I-B LOT 22 LOT AREA 38,309 ft² SITE CLASS. PS DESIGN FLOW 480 gpd L.T.A.R. n.25

Septic Tank: ~~1000~~ 1500 Gallons; STB 338 Date 12/3/01

Pump Tank: 1000 Gallons; PT 27 Date 11/6/01

Pump Make: Gowlas Model WEO 712 HH Serial No. 00158455

Nitrification Field: No Fields 1 Square Feet 960 Linear Feet 320

No Lines 4@80' Trench Width 36" Max Trench Bottom Depth 30" Gravel Depth NA

☑ New System ☐ Repair System Type: I, II, III, IV, V, VI

System Description: LP Panel Block

Repair System Description: Same

Maintenance Agreement Required: ☑ Yes ☐ No

☑ House/Mod. Home No. Bedrooms 4

☐ Mobile Home No. Bathrooms 4

☐ Business No. Employees _____

☐ Other _____

☐ Slab ☑ Crawl Space ☐ Basement w/plumbing ☐ Basement wo/plumbing

Water Supply: ☐ Individual ☑ Public ☑ Community


Comments:/Conditions:

Co-I-01 Reserved house & site plan approved substantially in compliance w/ I.P.

Comments:/Conditions:

1"=50'

INITIAL SITE SKETCH

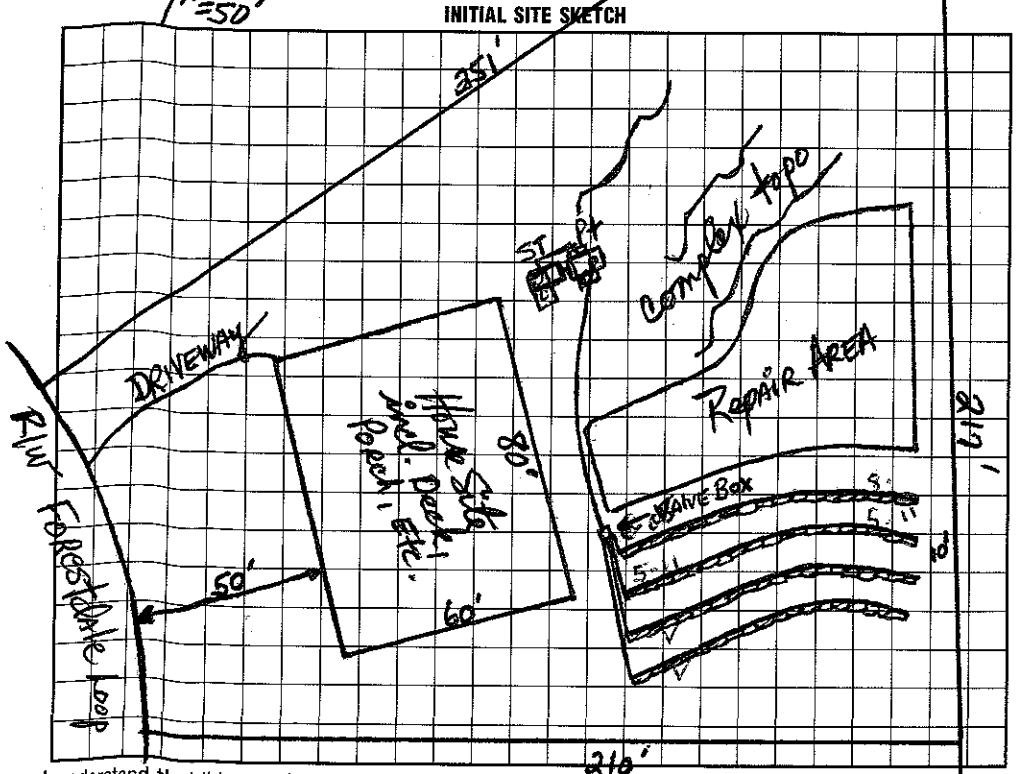

AS BUILT SKETCH

I understand that this permit can be suspended or revoked if any false information is supplied toward securing the permit/any unauthorized changes are made to the site/any unauthorized changes are made in the installation of the system. Improvement Permit with plat valid without expiration. Improvement Permit with site plan valid for sixty months. Authorization to Construct is valid for a period equal to that of Improvement Permit – not to exceed sixty months.

Signed: Tony Cyrus CPSS date 10-15-98 Installed by: Orbison Const. Co.

Improvement Permit by: _____ date 9-14-98 Operation Permit by: _____ date 3/11/02

Authorization to Construct by: _____ date 6-7-01 Existing System Inspection by: _____ date _____

HEALTH DEPT. COPY: WHITE INSPECTION COPY (FINAL): GREEN OWNER COPY (FINAL): YELLOW INSPECTION COPY (INITIAL): PINK OWNER COPY (INITIAL): GOLD