IREDELL COUNTY HEALTH DEPARTMENT

STATESVILLE 704-878-5305 MOORESVILLE 704-664-5281

IMPROVEMENT PERMIT / AUTHORIZATION TO CONSTRUCT / OPERATION PERMIT / EXISTING SYSTEM INSPECTION

PERMIT# 073887 PIN# 4625944684 4635-06-9689 DATE Sept. 14, 98

OWNER OR CONTRACTOR Crescent Resources Inc. // Arcadia Homes PHONE: Business Home

ADDRESS P.O. Box 1003, Charlotte

LOCATION Brawley Sch Rd TL Chesthaven Rd. TL Mayfair Rd. on Right

SUBDIVISION The Pointe BLOCK / SECTION 1-B LOT 25 LOT AREA 44,423 ft² SITE CLASS PS DESIGN FLOW 480 gpd L.T.A.R. .3

Septic Tank: 1000+ Gallons; STB 338 Date 9/27/99

Pump Tank: Gallons; PT Date

Pump Make: Model Serial No.

Nitrification Field: No Fields 1 Square Feet 1620 Linear Feet 540

No Lines 4@135' Trench Width 36" Max Trench Bottom Depth 36" Gravel Depth 12"

☑ New System ☐ Repair System Type: I, II, III, IV, V, VI

System Description: Gravity Conventional

Repair System Description: Gravity Conv. 25% Red.

Maintenance Agreement Required: ☐ Yes ☑ No

☑ House/Mod. Home No. Bedrooms 4

☐ Mobile Home No. Bathrooms 4

☐ Business No. Employees

☐ Other

☐ Slab ☑ Crawl Space ☐ Basement w/plumbing ☐ Basement wo/plumbing


Water Supply: ☐ Individual ☑ Public ☐ Community

Comments:/Conditions: 11-6-98 optional driveway location is acceptable - DRT.


4-1-99 Home & site plan reviewed; appears in compliance w/ I.P.

Comments:/Conditions:

INITIAL SITE SKETCH 1"=50'

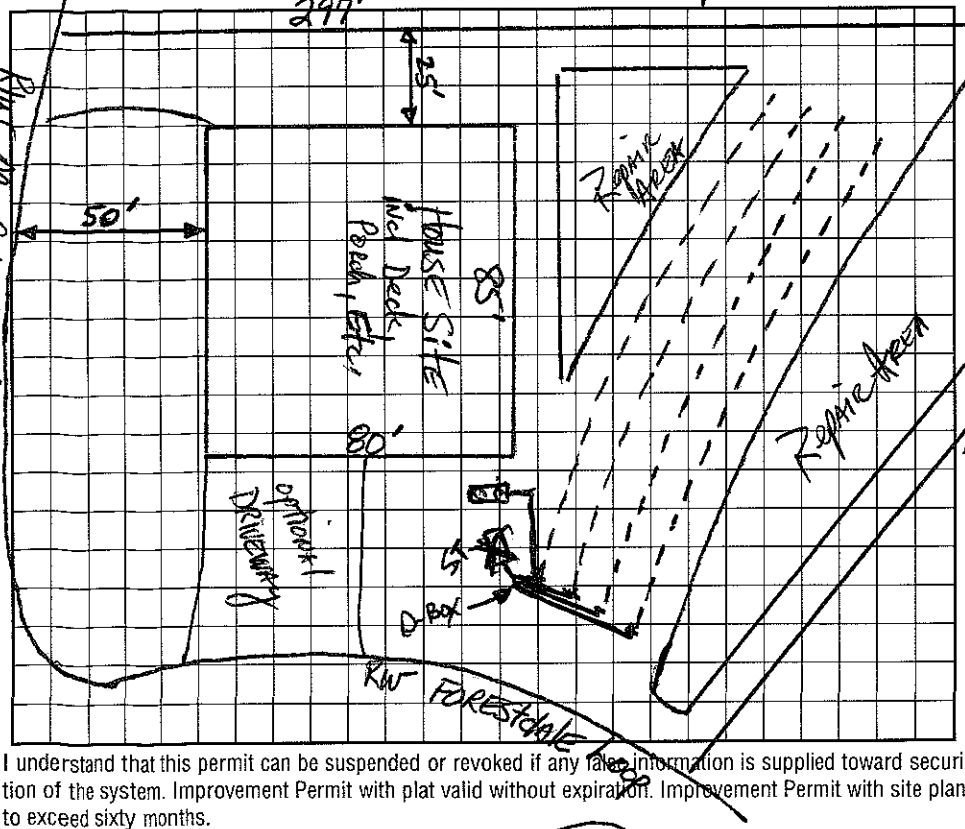

AS BUILT SKETCH

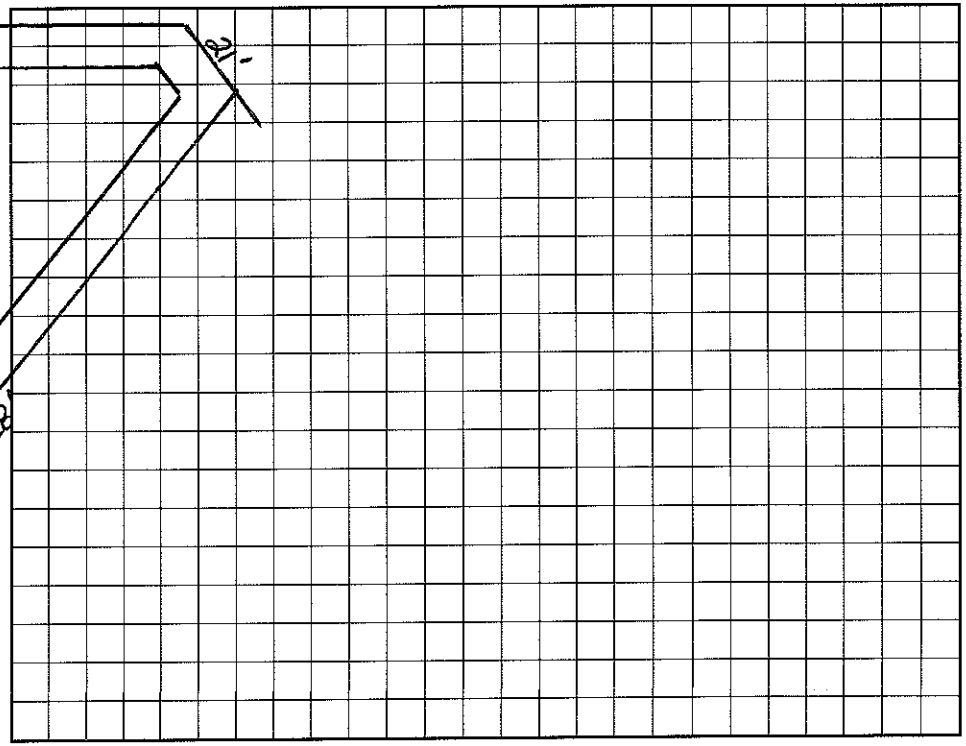

I understand that this permit can be suspended or revoked if any false information is supplied toward securing the permit/any unauthorized changes are made to the site/any unauthorized changes are made in the installation of the system. Improvement Permit with plat valid without expiration. Improvement Permit with site plan valid for sixty months. Authorization to Construct is valid for a period equal to that of Improvement Permit – not to exceed sixty months.

Signed: Tony Gross (agent) date 10-15-98

Improvement Permit by: Marvin L. Hinson, RS date 9-14-98

Authorization to Construct by: Marvin L. Hinson, RS date 4-1-99

Installed by: R + H Inc.

Operation Permit by: Wesley Sparks RS date 2/24/00

Existing System Inspection by: date

HEALTH DEPT. COPY: WHITE INSPECTION COPY (FINAL): GREEN OWNER COPY (FINAL): YELLOW INSPECTION COPY (INITIAL): PINK OWNER COPY (INITIAL): GOLD