Paid $50.00 Redraw 9/2/03

IREDELL COUNTY HEALTH DEPARTMENT

STATESVILLE 704-878-5305 MOORESVILLE 704-664-5281

IMPROVEMENT PERMIT / AUTHORIZATION TO CONSTRUCT / OPERATION PERMIT / EXISTING SYSTEM INSPECTIO

PERMIT# 074973 PIN# ~~4625-94-1084~~ 4635-07-3165 DATE 9-2-03

OWNER OR CONTRACTOR Ron Carroll PHONE: Business 400-1235 Home

ADDRESS P.O. Box 868 Cornelius, NC 28031

LOCATION Brawley School Rd TL Quaker Rd on right

SUBDIVISION The Point BLOCK / SECTION 1-C LOT 6 LOT AREA 30,077 Ft² SITE CLASS. PS DESIGN FLOW 450 gpd L.T.A.R. .25

Septic Tank: 1000 f Gallons; STB 338 Date 7-12-03
Pump Tank: 1000 Gallons; PT 283 Date 6-31-03
Pump Make: Model Serial No.
Nitrification Field: No Fields 1 Square Feet 960' Linear Feet 320
No Lines 6 Trench Width 36" Max Trench Bottom Depth 30" Gravel Depth N/A

☒ New System ☐ Repair System Type: I, II, III, (IV) V, VI (off site)
System Description: Pump-LP-Panel Block
Repair System Description: LP Panel Block
Maintenance Agreement Required: ☐ Yes ☐ No


☒ House/Mod. Home ☐ Mobile Home ☐ Business ☐ Other
No. Bedrooms 4 No. Bathrooms 4 No. Employees
☐ Slab ☐ Crawl Space ☒ Basement w/plumbing ☐ Basement wo/plumbing

Water Supply: ☐ Individual ☒ Public ☒ Community


Comments/Conditions: Keep Septic System at least 10' from PL & 50' from lake

Comments/Conditions: Note: If remains from Mulch pile are removed then lower lines may be longer. Checked lines 10/21/03 MJ

INITIAL SITE SKETCH

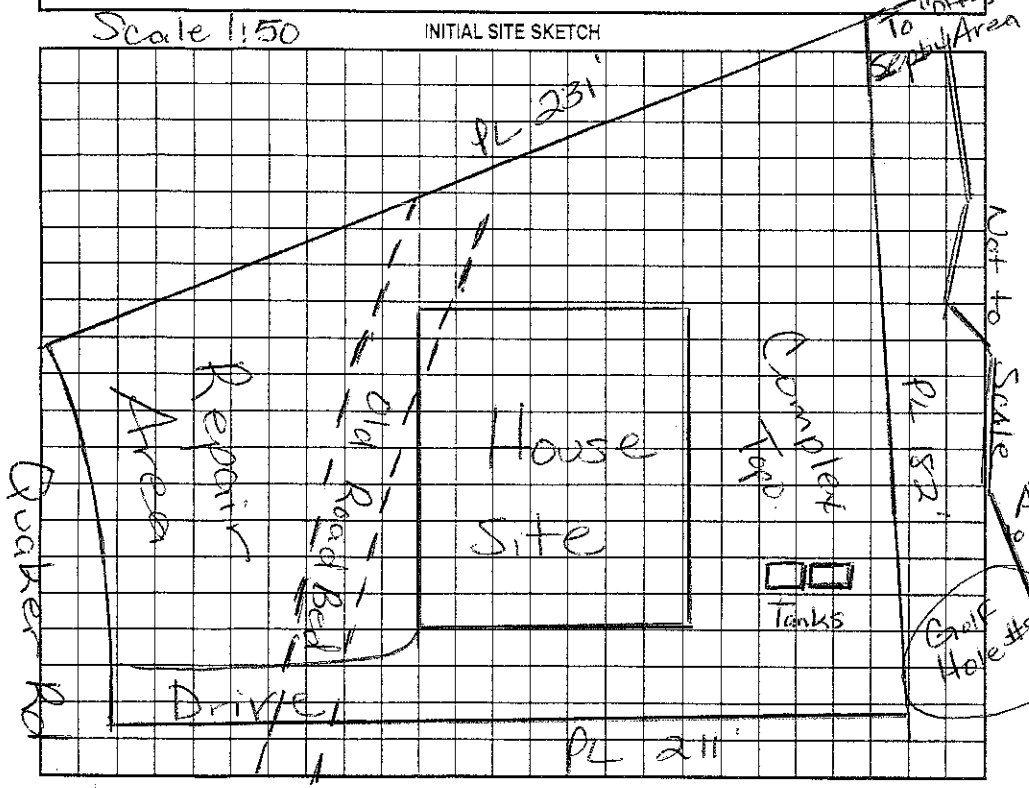

AS BUILT SKETCH

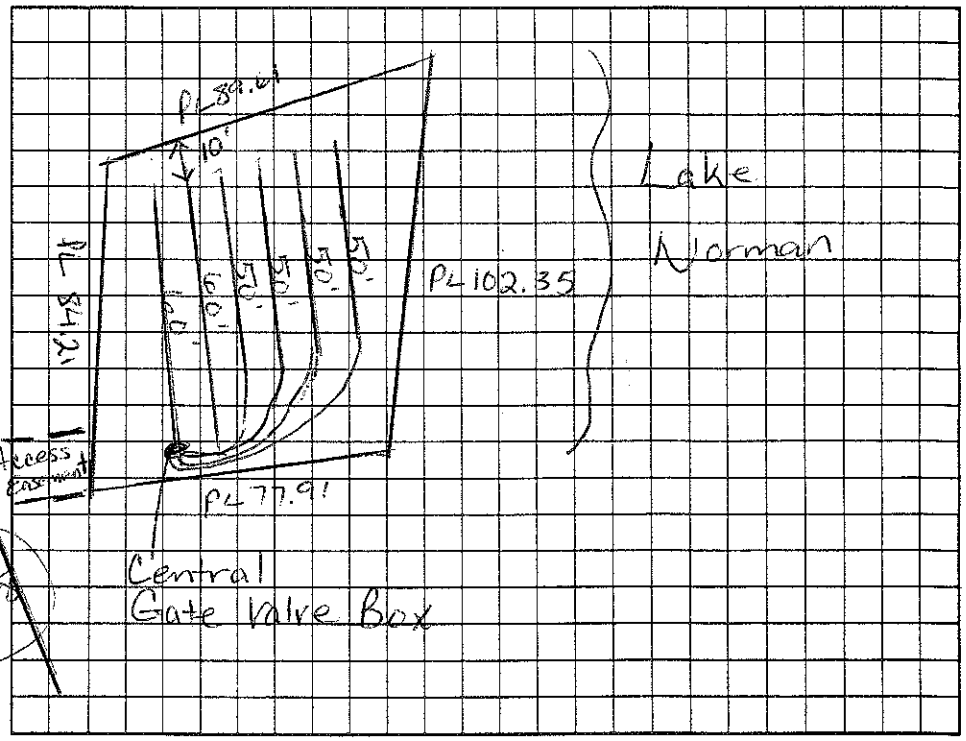

Permit can be suspended or revoked if any false information is supplied toward securing the permit/any unauthorized changes are made to the site/any unauthorized changes are made in the installation of the system. Improvement Permit with plat valid without expiration. Improvement Permit with site plan valid for sixty months. Authorization to Construct is valid for a period equal to that of Improvement Permit – not to exceed sixty months.

Signed: date 9-03-03

Improvement Permit by: Maria H. Dolan RS date 9/2/03

Authorization to Construct by: Maria H. Dolan RS date 9/2/03

Installed by: R & H

Operation Permit by: Maria H. Dolan RS date 11/17/03

Existing System Inspection by: date

HEALTH DEPT. COPY: WHITE OWNER COPY (FINAL): YELLOW OWNER COPY (INITIAL): PINK