As Built

IREDELL COUNTY HEALTH DEPARTMENT

STATESVILLE 704-878-5305 MOORESVILLE 704-664-5281

IMPROVEMENT PERMIT / AUTHORIZATION TO CONSTRUCT / OPERATION PERMIT / EXISTING SYSTEM INSPECTION

PERMIT# 124790 PIN# 4625944684 4635-07-4218 DATE 12-1-05

OWNER OR APPLICANT Augusta Homes PHONE: Business _____ Home _____

ADDRESS 0602 Bailey Rd

LOCATION Brawley School Rd IC Quaker Rd on Rt

SUBDIVISION The Point BLOCK / SECTION 1-C LOT 7 LOT AREA 46551 ft2 SITE CLASS PS DESIGN FLOW 480 gpd L.T.A.R. ~~.35~~ .3

Septic Tank: 1500 Gallons; STB 338 Date 6-6-05
Pump Tank: 1000 Gallons; PT 283 Date 6-6-05
Pump Make: Goulds Model WE03121M Serial No. _____
Nitrification Field: No Fields 1 Square Feet 810 Linear Feet 270'
No Lines 7 Trench Width 36" Max Trench Bottom Depth 36

☒ New System ☐ Repair ☐ Expansion System Type: I II III IV V VI
System Description: Pump-Lp-Panel Blk
Repair System Description: Same
Maintenance Agreement Required: ☒ Yes ☐ No
Gravel Depth: 1/4 ☐ Gravity ☐ Pressure ☐ Slab ☒ Crawl Space ☐ Basement w/plumbing ☐ Basement wo/plumbing

☒ House/Mod. Home No. Bedrooms 4
☐ Mobile Home No. Persons ____
☐ Business No. Employees ____
☐ Other _____


Water Supply: ☐ Individual ☒ Public ☒ Community

Comments:/Conditions:


Scale 1" = 50'

Comments:/Conditions:

INITIAL SITE SKETCH

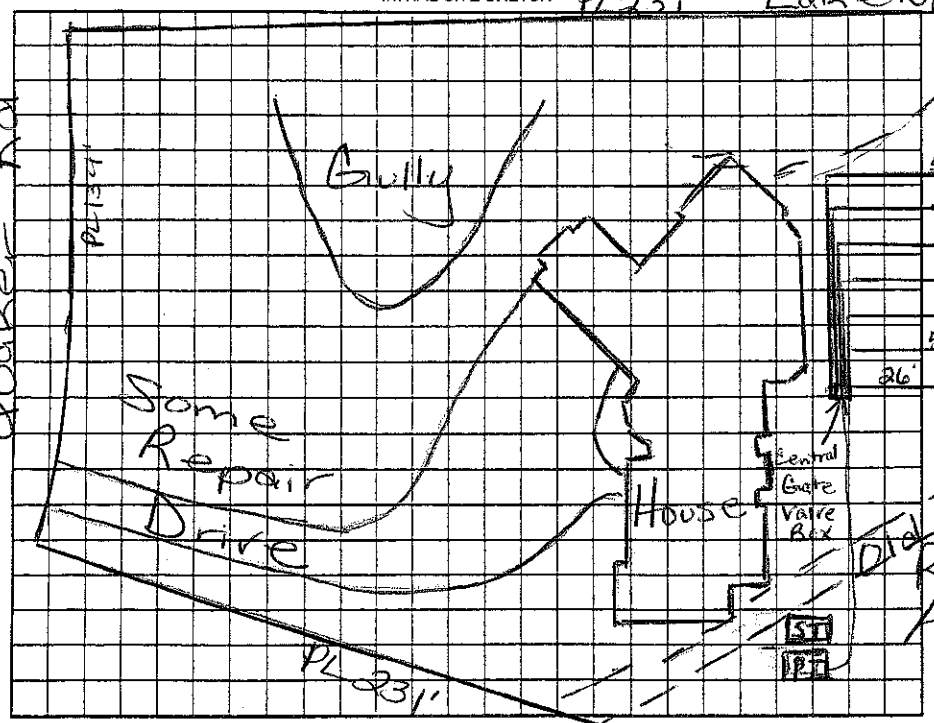

AS BUILT SKETCH

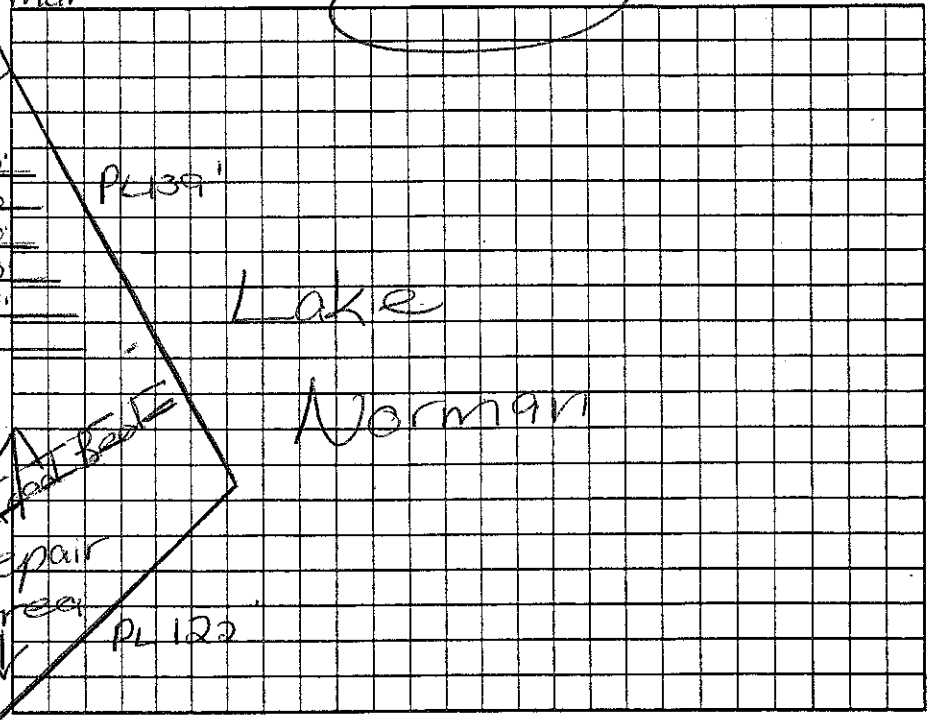

Permit can be suspended or revoked if any false information is supplied toward securing the permit/any unauthorized changes are made to the site/any unauthorized changes are made in the installation of the system. Improvement Permit with plat valid without expiration ☐ Improvement Permit with site plan valid for sixty months ☐ Authorization to Construct is valid for a period equal to that of Improvement Permit – not to exceed sixty months.

Signed: X Frank Benner date 12/1/05

Improvement Permit by: Maina W. Dolan RS date 12/1/05

Authorization to Construct by: Maina W. Dolan RS date 12/1/05

Installed by: R & H

Operation Permit by: Maina W. Dolan RS date 12/1/05

Existing System Inspection by: _____ date _____

HEALTH DEPT. COPY: WHITE OWNER COPY (FINAL): YELLOW OWNER COPY (INITIAL): PINK