12479O

IREDELL COUNTY HEALTH DEPARTMENT

STATESVILLE 704-878-5305 MOORESVILLE 704-664-5281

IMPROVEMENT PERMIT / AUTHORIZATION TO CONSTRUCT / OPERATION PERMIT / EXISTING SYSTEM INSPECTION

PERMIT# 074974 PIN# 4625941684 DATE 2/17/03

OWNER OR CONTRACTOR Augusta Homes PHONE: Business Home

ADDRESS 10602 Bailey Rd Suite B Cornelius NC 28031

LOCATION Brawley Sch, TL Quaker Rd on Rt.

SUBDIVISION The Point BLOCK / SECTION 1-C LOT 7 LOT AREA 46,581 Ft² SITE CLASS. PS DESIGN FLOW 480 L.T.A.R. 1.0,3

Septic Tank: ~~1000~~ 1500 Gallons; STB 338 Date 6-6-05

Pump Tank: 1000 Gallons; PT 283 Date 6-6-05

Pump Make: Goulds Model WE0312MU Serial No.

Nitrification Field: No Fields 1 Square Feet 810 Linear Feet 270

No Lines 5 (7) Trench Width 36" Max Trench Bottom Depth 36" Gravel Depth —

☒ New System ☐ Repair System Type: I, II, III, (IV), V, VI

System Description: LP Panel Block

Repair System Description: Same

Maintenance Agreement Required: ☒ Yes ☐ No

☒ House/Mod. Home No. Bedrooms 4

☐ Mobile Home No. Bathrooms 4

☐ Business No. Employees

☐ Other


☐ Slab ☒ Crawl Space ☐ Basement w/plumbing ☐ Basement wo/plumbing

Water Supply: ☐ Individual ☐ Public ☒ Community


Comments:/Conditions:

Comments:/Conditions: Checked lines 6/23/05
Tanks Checked by MD
Pressure Checked by WS

INITIAL SITE SKETCH 1"=50'

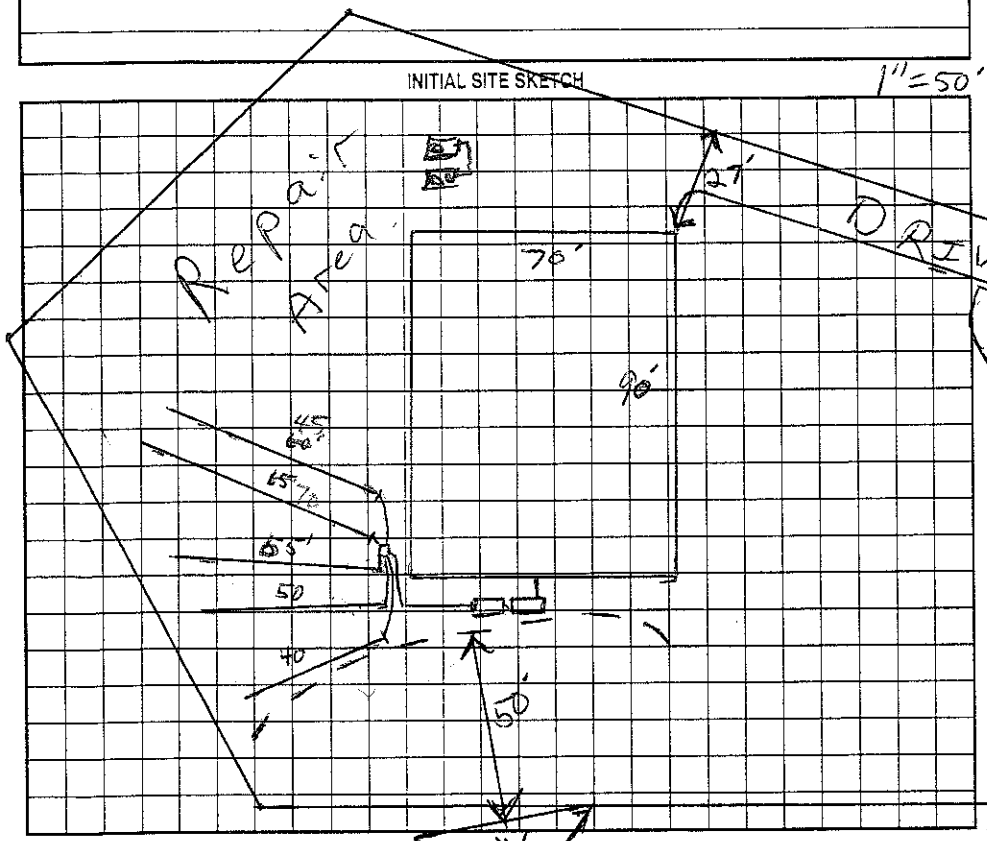

AS BUILT SKETCH

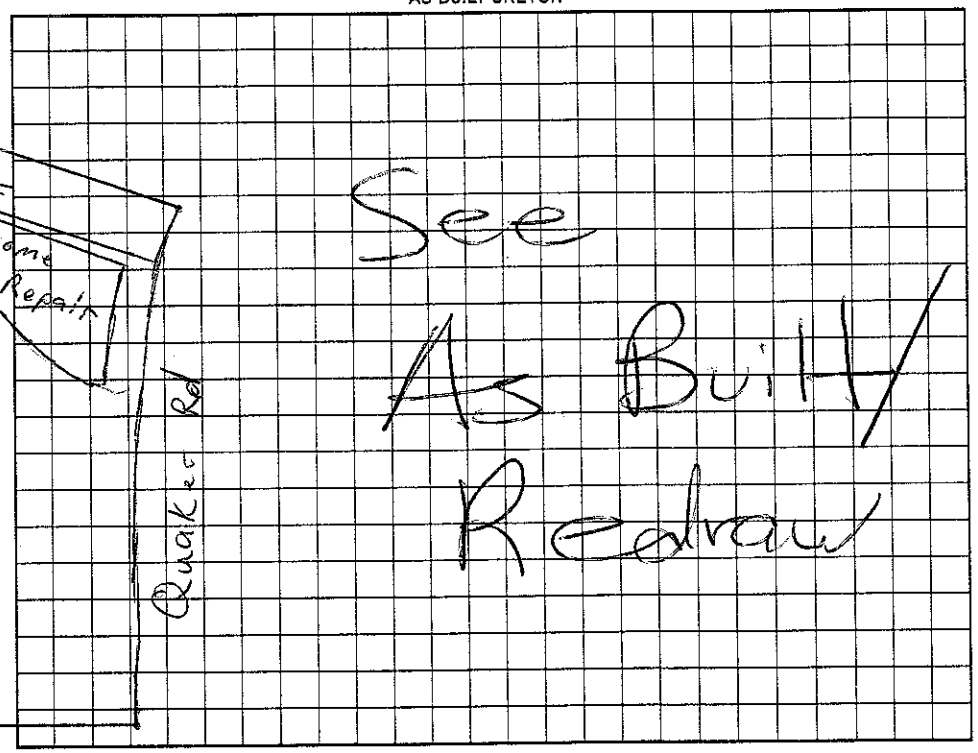

Permit can be suspended or revoked if any false information is supplied toward securing the permit/any unauthorized changes are made to the site/any unauthorized changes are made in the installation of the system. Improvement Permit with plat valid without expiration. Improvement Permit with site plan valid for sixty months. Authorization to Construct is valid for a period equal to that of Improvement Permit – not to exceed sixty months.

Signed: [signature] date 2/18/03 Installed by: R&H Dolan RS

Improvement Permit by: [signature] RS date 2/17/03 Operation Permit by: [signature] date 12/1/05

Authorization to Construct by: [signature] RS date 10/15/04 Existing System Inspection by: date

HEALTH DEPT. COPY: WHITE OWNER COPY (FINAL): YELLOW OWNER COPY (INITIAL): PINK