IREDELL COUNTY HEALTH DEPARTMENT

STATESVILLE 704-878-5305 MOORESVILLE 704-664-5281

IMPROVEMENT PERMIT / AUTHORIZATION TO CONSTRUCT / OPERATION PERMIT / EXISTING SYSTEM INSPECTION

PERMIT# 74991 PIN# 4625944684 4635-07-4939 DATE 8/2/01

OWNER OR CONTRACTOR CRESCENT RESOURCES / BROOKSHIRE CONST. PHONE: Business 895-8670 Home

ADDRESS 1990 West CASTLE · CORNELIUS · NC 28031

LOCATION BRAWLEY SCHOOL- TL QUAKER RD-ON LT

SUBDIVISION POINT BLOCK / SECTION 1C LOT 26 LOT AREA .29254A SITE CLASS. PS DESIGN FLOW 360 GPD L.T.A.R. 36-10/RT2

Septic Tank: 1500 Gallons; STB 338 Date 1/20/02

Pump Tank: 1000 Gallons; PT 283 Date 12/16/01

Pump Make: Gould's Model WE0512HHa Serial No G0158369

Nitrification Field: No Fields 1 Square Feet 500 Linear Feet 250

No Lines 5@50' Trench Width 24"-36" Max Trench Bottom Depth 36" Gravel Depth N/A

☑ New System ☐ Repair System Type: I, II, III, IV, V, VI

System Description: CP PANEL

Repair System Description: SAME

Maintenance Agreement Required: ☑ Yes ☐ No

☐ House/Mod. Home No. Bedrooms 3

☐ Mobile Home No. Bathrooms 3

☐ Business No. Employees

☐ Other


☐ Slab ☑ Crawl Space ☐ Basement w/plumbing ☐ Basement wo/plumbing

Water Supply: ☐ Individual ☐ Public ☑ Community

Comments:/Conditions:

Comments:/Conditions: Separate venting for S/T.

INITIAL SITE SKETCH 1" = 50'

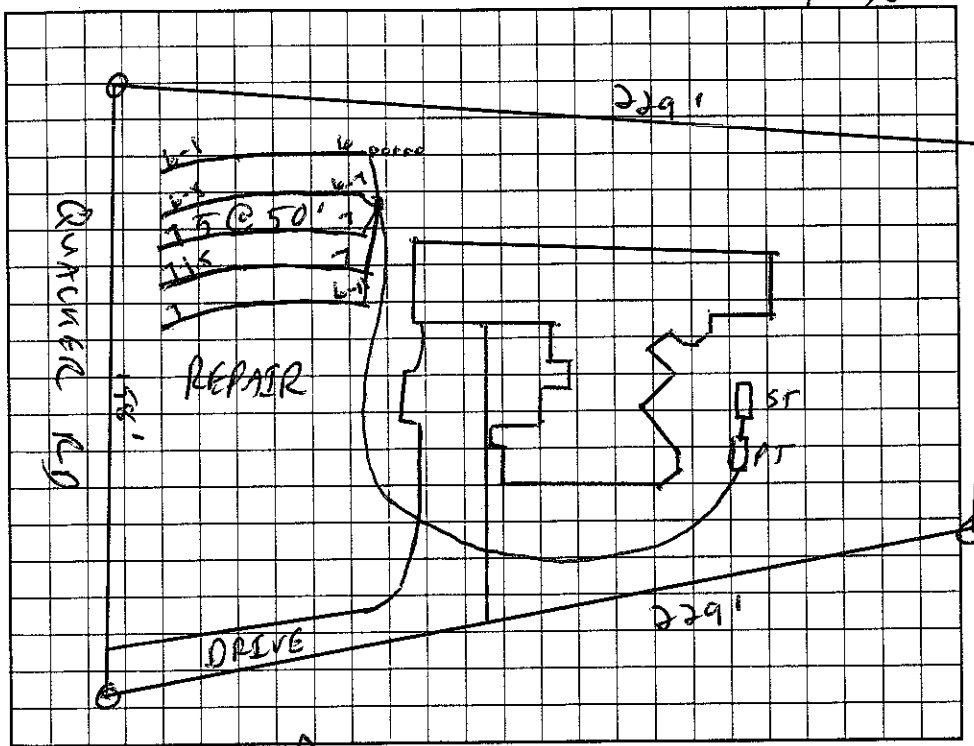

AS BUILT SKETCH

Permit can be suspended or revoked if any false information is supplied toward securing the permit/any unauthorized changes are made to the site/any unauthorized changes are made in the installation of the system. Improvement Permit with plat valid without expiration. Improvement Permit with site plan valid for sixty months. Authorization to Construct is valid for a period equal to that of Improvement Permit – not to exceed sixty months.

Signed: _____ date 8/3/01 Installed by: Hallman Const.

Improvement Permit by: _____ RS date 8/2/01 Operation Permit by: Wesley Sparks RS date 4/15/02

Authorization to Construct by: _____ RS date 8/2/01 Existing System Inspection by: _____ date _____

HEALTH DEPT. COPY: WHITE OWNER COPY (FINAL): YELLOW OWNER COPY (INITIAL): PINK