IREDELL COUNTY HEALTH DEPARTMENT

STATESVILLE 704-878-5305 50.00 Paid MOORESVILLE 704-664-5281 3:00

IMPROVEMENT PERMIT / AUTHORIZATION TO CONSTRUCT / OPERATION PERMIT / EXISTING SYSTEM INSPECTION

PERMIT# 075008 (Chester SC Site) PIN# 4625944684 4635-07-8799 DATE 9-16-04

OWNER OR CONTRACTOR Arcadia Homes PHONE: Business 704 201-7181 Home

ADDRESS 315 Main St. Suite E Pineville, NC 28134 198 Quaker

LOCATION Brawley School Road TL Quaker on Rt near end

SUBDIVISION The Point BLOCK / SECTION 1-C LOT 11 LOT AREA 45,693 ft² SITE CLASS. PS DESIGN FLOW 600 L.T.A.R. .25

Septic Tank: 1500 Gallons; STB Date

Pump Tank: 1500 Gallons; PT Date

Pump Make: Model Serial No.

Nitrification Field: No Fields 1 Square Feet 1200 Linear Feet 400'

No Lines 5@80' Trench Width 24"-36" Max Trench Bottom Depth 36" Gravel Depth N/A

☒ New System ☐ Repair System Type: I, II, III, IV, V, VI

System Description: Pump-LP- Panel Block

Repair System Description: Same

Maintenance Agreement Required: ☒ Yes ☐ No

☒ House/Mod. Home No. Bedrooms 5

☐ Mobile Home No. Bathrooms 5

☐ Business No. Employees

☐ Other


☐ Slab ☒ Crawl Space ☒ Basement w/plumbing ☐ Basement wo/plumbing

Water Supply: ☐ Individual ☒ Public ☒ Community


Comments/Conditions: Note: Swimming Pool must be at least 15' From any part of Septic system. Do Not stub out plumbing real deep.

Comments/Conditions: Checked tanks Partial lines 4/18/05 MP Pressure, electrical & alarm 8/16/05

INITIAL SITE SKETCH Scale 1:50

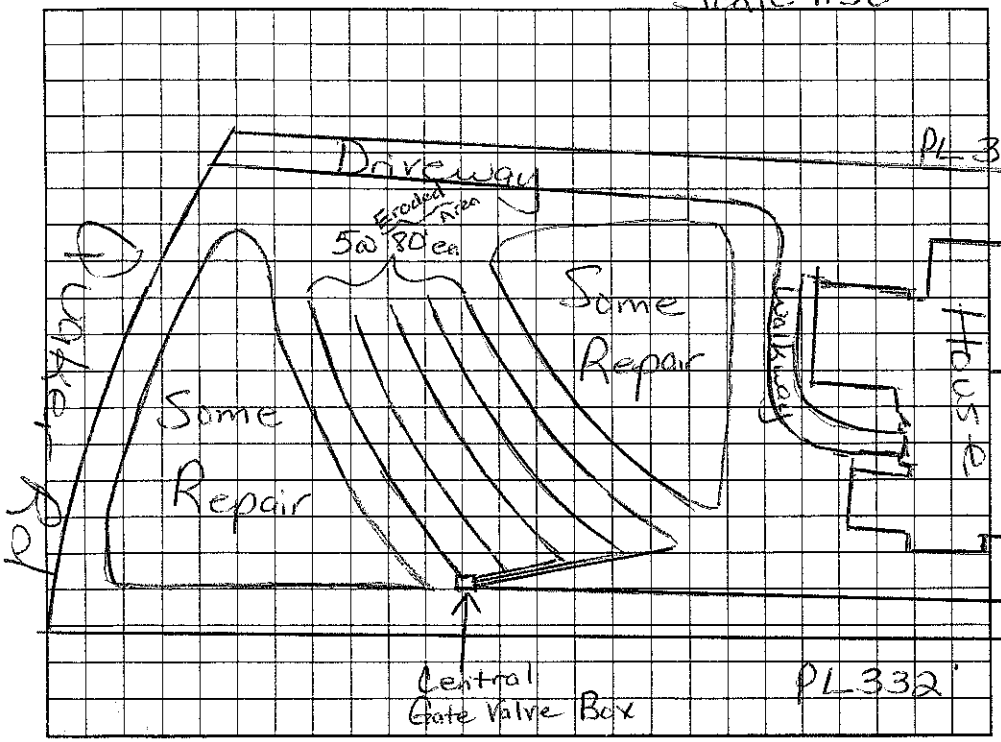

AS BUILT SKETCH

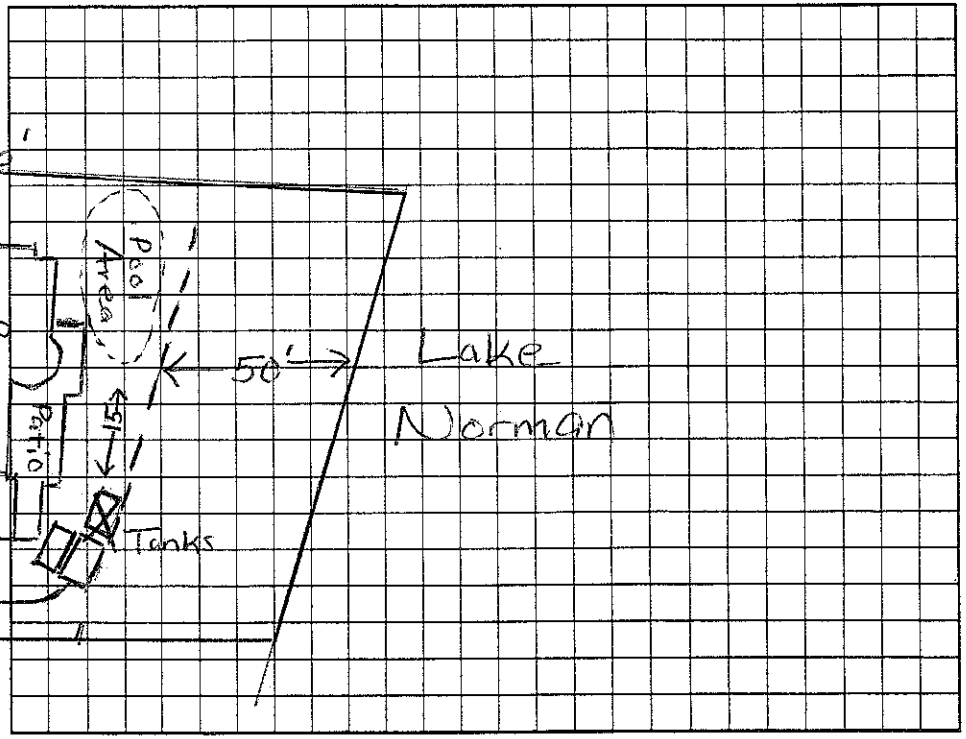

Permit can be suspended or revoked if any false information is supplied toward securing the permit/any unauthorized changes are made to the site/any unauthorized changes are made in the installation of the system. Improvement Permit with plat valid without expiration. Improvement Permit with site plan valid for sixty months. Authorization to Construct is valid for a period equal to that of Improvement Permit – not to exceed sixty months.

Signed: Jamie A. Weeks date 9/22/04 Installed by: R & H

Improvement Permit by: Maria H. Dotson RS date 9/17/04 Operation Permit by: Maria H. Dotson RS date 8/16/05

Authorization to Construct by: Maria H. Dotson RS date 9/17/04 Existing System Inspection by: date

HEALTH DEPT. COPY: WHITE OWNER COPY (FINAL): YELLOW OWNER COPY (INITIAL): PINK