IREDELL COUNTY HEALTH DEPARTMENT

STATESVILLE 704-878-5305 MOORESVILLE 704-664-5281

IMPROVEMENT PERMIT / AUTHORIZATION TO CONSTRUCT / OPERATION PERMIT / EXISTING SYSTEM INSPECTION

PERMIT# 074986 PIN# 4625941684 (pt) 4635-08-2022 DATE June 21, '99

OWNER OR CONTRACTOR Crescent Resources Inc. / Allenst Custom Homes PHONE: Business 660-1185 Home

ADDRESS 2214 Brawley Sch Rd. Mooresville

LOCATION Brawley Sch Rd. TR Quaker Rd. on left

SUBDIVISION The Point BLOCK / SECTION 1-C LOT 27 LOT AREA 52,602 ft² SITE CLASS. PS DESIGN FLOW 460 gpd L.T.A.R. .3

Septic Tank: ~~1000~~ 1500 Gallons; STB 797 Date 8/23/99

Pump Tank: 1000 Gallons; PT 27 Date 8/30/99

Pump Make: MYERS Model ME-3F Serial No. 8/99

Nitrification Field: No Fields 1 Square Feet 1200 Linear Feet 400

No Lines 1 @ 100 Trench Width 36" Max Trench Bottom Depth 36" Gravel Depth NA

☑ New System ☐ Repair System Type: I, II, (III) IV, V, VI

System Description: PM - Innovative - 25% Reduction

Repair System Description: SAME

Maintenance Agreement Required: ☐ Yes ☑ No

☑ House/Mod. Home ☐ Mobile Home ☐ Business ☐ Other

No. Bedrooms 4 No. Bathrooms 4 No. Employees

☐ Slab ☑ Crawl Space ☐ Basement w/plumbing ☐ Basement wo/plumbing

Water Supply: ☐ Individual ☑ Public ☑ Community


Comments:/Conditions: * DWE inspection fee per LATERAL

This permit replaces permit of 11-14-98


Comments:/Conditions:

1"=50'

INITIAL SITE SKETCH

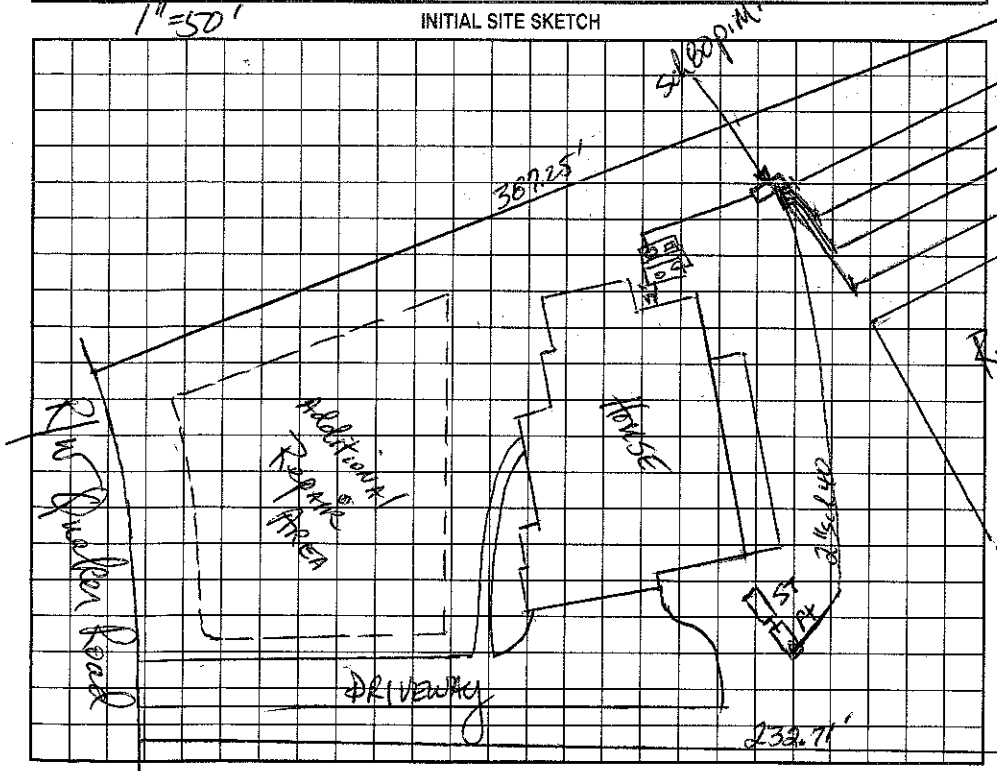

AS BUILT SKETCH

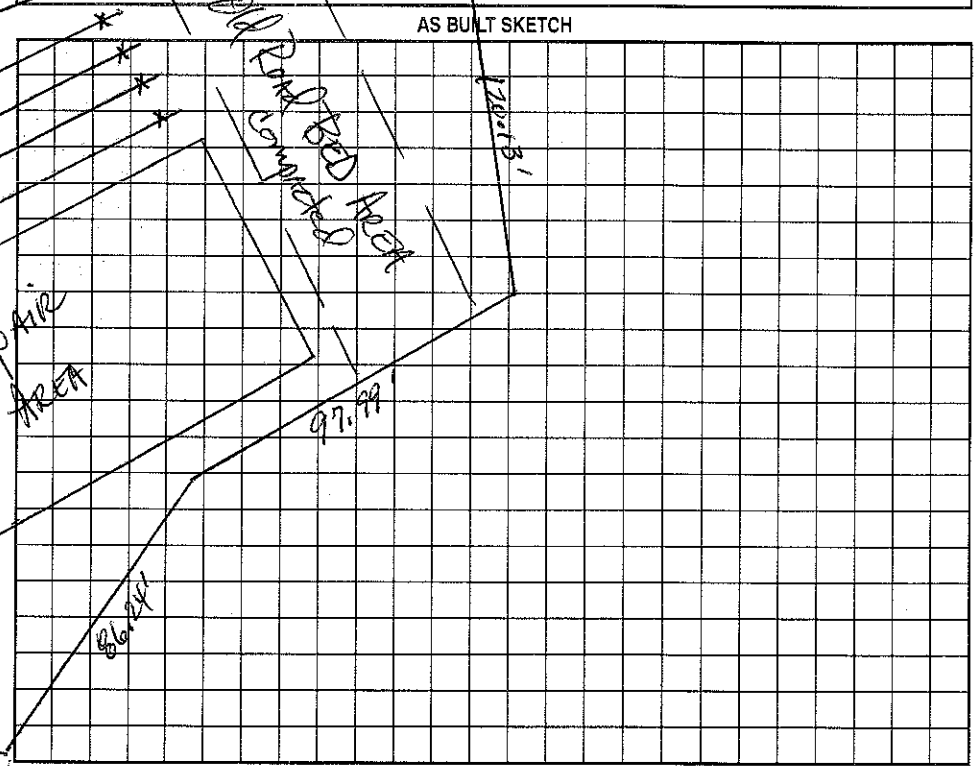

Permit can be suspended or revoked if any false information is supplied toward securing the permit/any unauthorized changes are made to the site/any unauthorized changes are made in the installation of the system. Improvement Permit with plat valid without expiration. Improvement Permit with site plan valid for sixty months. Authorization to Construct is valid for a period equal to that of Improvement Permit – not to exceed sixty months.

Signed: date 6/22/99 Installed by: H+R

Improvement Permit by: date 6-21-99 Operation Permit by: Wesley Sparks R.S. date 2/7/00

Authorization to Construct by: date 6-21-99 Existing System Inspection by: date

HEALTH DEPT. COPY: WHITE OWNER COPY (FINAL): YELLOW OWNER COPY (INITIAL): PINK