IREDELL COUNTY HEALTH DEPARTMENT

STATESVILLE 704-878-5305 MOORESVILLE 704-664-5281

IMPROVEMENT PERMIT / AUTHORIZATION TO CONSTRUCT / OPERATION PERMIT / EXISTING SYSTEM INSPECTION

2108

PERMIT# 075001 PIN# 4625944684 4635 08 9281 DATE Oct. 24, '98

OWNER OR CONTRACTOR Crescent Resources Inc // Tom Stevenson Bld. PHONE: Business _____ Home _____

ADDRESS P.O. Box 1903, Charlotte

LOCATION Brawley School Rd. TL Quicker Rd. TL Hadley Harbor Ct. immediately on Right 106 Hadley Harbor Ct.

SUBDIVISION The Point BLOCK / SECTION I-C LOT 18 LOT AREA 44,348 ft² SITE CLASS. PS DESIGN FLOW 480 gpd L.T.A.R. 0.25

Septic Tank: 1000 Gallons; STB 338 Date 3-2-02

Pump Tank: 1000 Gallons; PT 283 Date 3-4-02

Pump Make: Myers, Model ME 50 Serial No. _____

Nitrification Field: No. Fields 1 Square Feet 1500 Linear Feet 500

No Lines 5@100' Trench Width 36" Max Trench Bottom Depth 36" Gravel Depth NA

☑ New System ☐ Repair System Type: I, II, III, IV, V, VI

System Description: Pumped pressure - 25% Reduction

Repair System Description: LPP Panel Block

Maintenance Agreement Required: ☐ Yes ☑ No

☑ House/Mod. Home ☐ Mobile Home ☐ Business ☐ Other

No. Bedrooms 4 No. Bathrooms 4 No. Employees _____


☑ Slab ☑ Crawl Space ☑ Basement w/plumbing ☐ Basement wo/plumbing

Water Supply: ☐ Individual ☑ Public ☑ Community


Comments:/Conditions: * ONE inspection port per LATERAL.
Remove any old burned/terraces!
5-31-01 Reviewed site & floor plans, appears in compliance w/ IP dated 1"=50'

Comments:/Conditions: (PARTIAL) Checked lines & tanks 4/11/2002 tmp
EZ Flow Drainfield installed

INITIAL SITE SKETCH

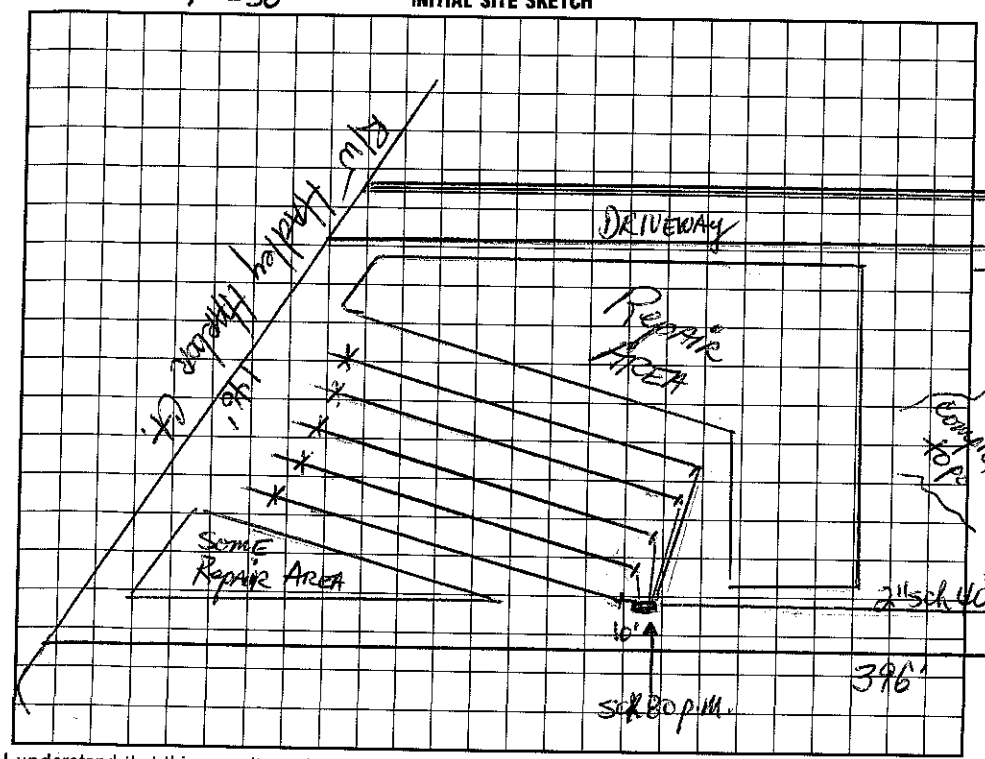

AS BUILT SKETCH

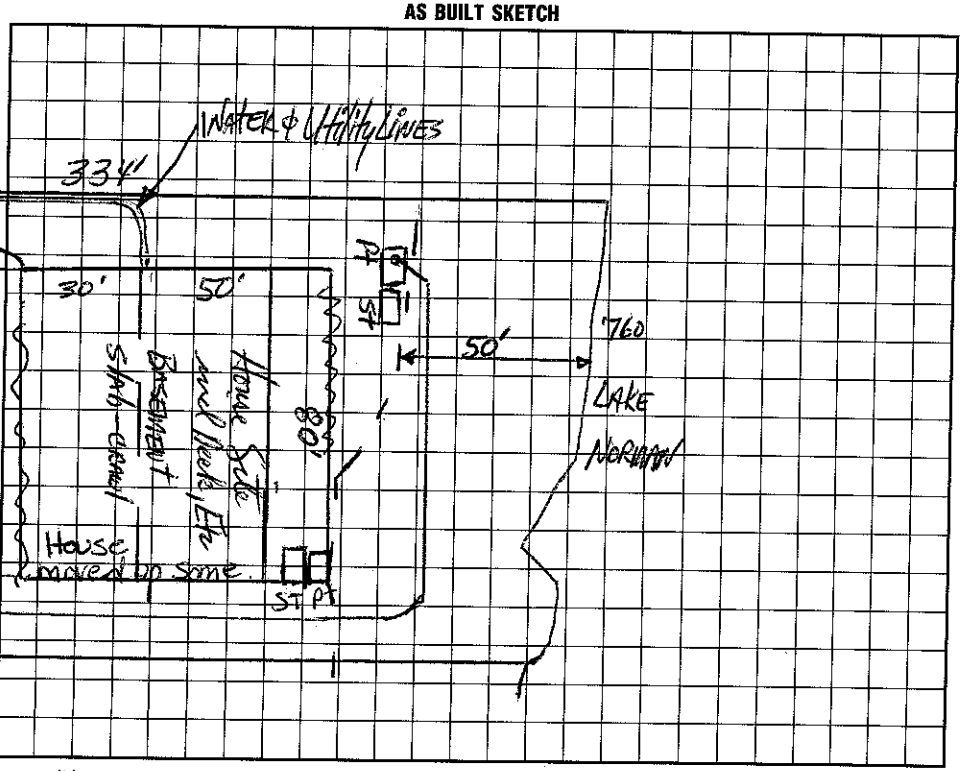

I understand that this permit can be suspended or revoked if any false information is supplied toward securing the permit/any unauthorized changes are made to the site/any unauthorized changes are made in the installation of the system. Improvement Permit with plat valid without expiration. Improvement Permit with site plan valid for sixty months. Authorization to Construct is valid for a period equal to that of Improvement Permit – not to exceed sixty months.

Signed: _____ date 10-30-98

Improvement Permit by: _____ RS date 10-24-98

Authorization to Construct by: _____ RS date 5-31-01

Installed by: R & H Inc.

Operation Permit by: _____ RS date 8/14/02

Existing System Inspection by: _____ date _____

HEALTH DEPT. COPY: WHITE INSPECTION COPY (FINAL): GREEN OWNER COPY (FINAL): YELLOW INSPECTION COPY (INITIAL): PINK OWNER COPY (INITIAL): GOLD