1130

IREDELL COUNTY HEALTH DEPARTMENT

STATESVILLE 704-878-5305 MOORESVILLE 704-664-5281

IMPROVEMENT PERMIT / AUTHORIZATION TO CONSTRUCT / OPERATION PERMIT / EXISTING SYSTEM INSPECTION

PERMIT# 075800 PIN# ~~4635-44-4834~~ 4635-08-9343 DATE Oct-24-'98

OWNER OR CONTRACTOR Crescent Resources Inc. / Arcadia Homes PHONE: Business _____ Home _____

ADDRESS P.O. Box 1023, Charlotte

LOCATION Brawley School Rd. TL Quaker Rd. TL Hadley Harbor Ct. on Right

SUBDIVISION The Point BLOCK / SECTION 1-C LOT 19 LOT AREA 36,303 ft² SITE CLASS. RS DESIGN FLOW 480 gpd L.T.A.R. .25

Septic Tank: 1500 Gallons; STB 338 Date 7/9/99

Pump Tank: 1000 Gallons; PT 27 Date 9/22/99

Pump Make: MYERS Model ME-100 Serial No. _____

Nitrification Field: No Fields 1 Square Feet 960 Linear Feet 320

No Lines 6 Trench Width 36" Max Trench Bottom Depth ~30" Gravel Depth NA

☑ New System ☐ Repair System Type: I, II, III, IV, V, VI

System Description: LPP Panel Block

Repair System Description: SAME

Maintenance Agreement Required: ☑ Yes ☐ No

☑ House/Mod. Home ☐ Mobile Home ☐ Business ☐ Other

No. Bedrooms 4 No. Bathrooms 4 No. Employees _____

☑ Slab ☑ Crawl Space ☑ Basement w/plumbing ☐ Basement wo/plumbing

Water Supply: ☐ Individual ☑ Public ☐ Community

Comments:/Conditions: Remove any old burn, terraces


Reviewed revised house plan and site plan - now appears in compliance w/ LP 2-8-99 DRET

Comments:/Conditions: (PARTIAL)


10/24/99 Drainlines Checked

11/1/99 Checked Tanks

INITIAL SITE SKETCH 1"=50'

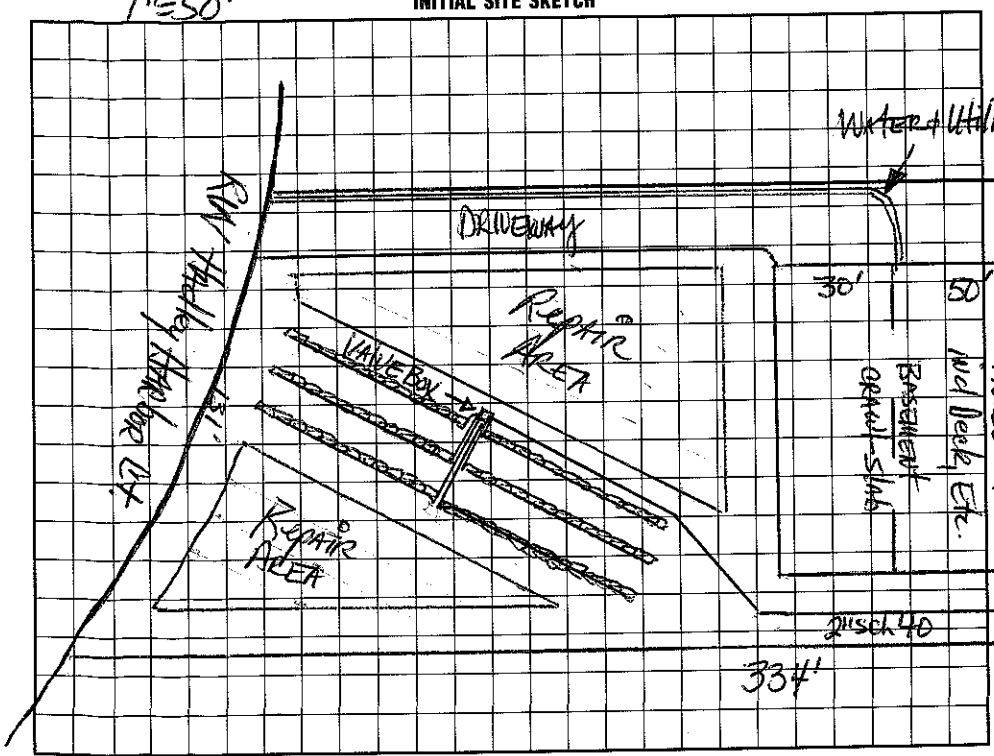

AS BUILT SKETCH

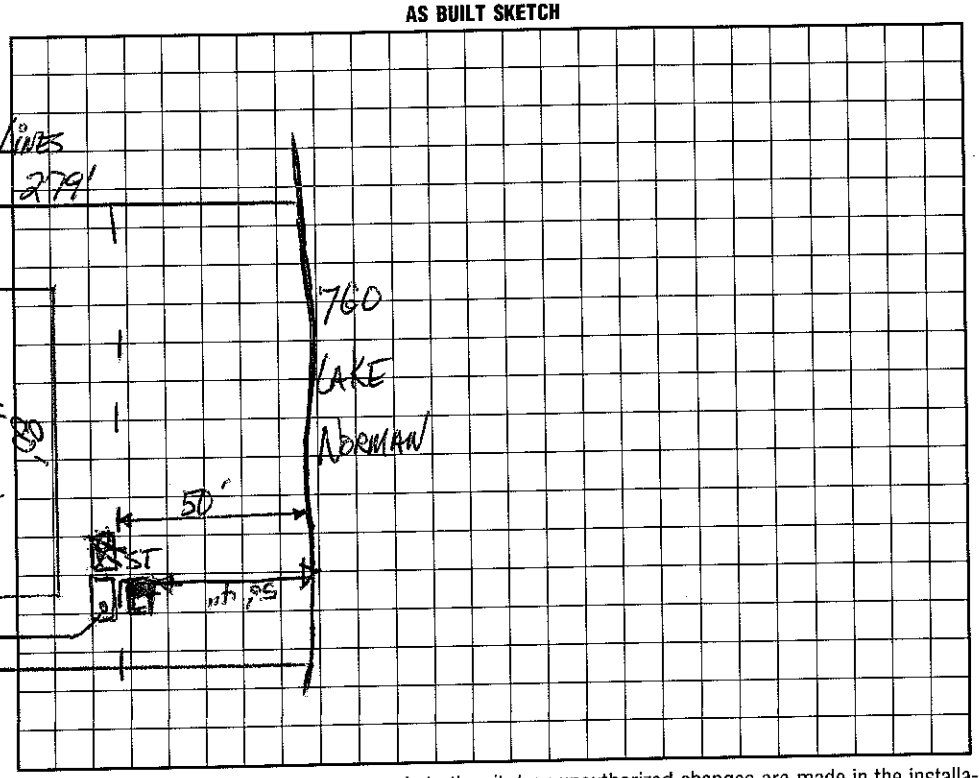

I understand that this permit can be suspended or revoked if any false information is supplied toward securing the permit/any unauthorized changes are made to the site/any unauthorized changes are made in the installation of the system. Improvement Permit with plat valid without expiration. Improvement Permit with site plan valid for sixty months. Authorization to Construct is valid for a period equal to that of Improvement Permit – not to exceed sixty months.

Signed: _____ date 10-30-98 Installed by: R+H Inc.

Improvement Permit by: _____ date 10-24-98 Operation Permit by: Wesley Sparks RS date 12/9/99

Authorization to Construct by: _____ date 2-13-99 Existing System Inspection by: _____ date _____

HEALTH DEPT. COPY: WHITE INSPECTION COPY (FINAL): GREEN OWNER COPY (FINAL): YELLOW INSPECTION COPY (INITIAL): PINK OWNER COPY (INITIAL): GOLD