IREDELL COUNTY HEALTH DEPARTMENT

STATESVILLE 704-878-5305 — MOORESVILLE 704-664-5281

IMPROVEMENT PERMIT / AUTHORIZATION TO CONSTRUCT / OPERATION PERMIT / EXISTING SYSTEM INSPECTION

PERMIT# 116804 PIN# ~~4625941684~~ 4635-08-9405 Bill DATE 8-10-04

OWNER OR CONTRACTOR Hughes & Assoc. PHONE: Business 361-5893 Home

ADDRESS 10425-A Bannington Dr. Charlotte, NC 28227

LOCATION 1100 Tl Quaker Rd Tl Hadley Harbor Ct on R at end

SUBDIVISION Point BLOCK / SECTION 1-C LOT 20 LOT AREA 36,858 SITE CLASS. PS DESIGN FLOW 600 L.T.A.R. .3

Septic Tank: 1500 Gallons; STB 338 Date 7-16-04
Pump Tank: 1500 Gallons; PT 421 Date 7-17-04
Pump Make: Myers Model Serial No.
Nitrification Field: No Fields 1 Square Feet 1005 Linear Feet 335'
No Lines 5 Trench Width 24"-36" Max Trench Bottom Depth 36" Gravel Depth N/A

☒ New System ☐ Repair System Type: I, II, III, IV, V, VI
System Description: Pump - LP - Panel Block
Repair System Description: Same
Maintenance Agreement Required: ☒ Yes ☐ No


☐ House/Mod. Home No. Bedrooms
☐ Mobile Home No. Bathrooms
☐ Business No. Employees
☐ Other
☐ Slab ☐ Crawl Space ☒ Basement w/plumbing ☐ Basement wo/plumbing

Water Supply: ☐ Individual ☒ Public ☐ Community


Comments/Conditions: Keep Septic System at least 10' From PL, & 50 from lake.
* Note: a 10 foot section of 4" pipe is needed in front of Septic tank when using grinder pump.

Comments/Conditions: Installed as Drawn
Tanks & lines checked 8/24/04
Pressure, float & alarm checked 12/22/04

INITIAL SITE SKETCH Scale 1:50

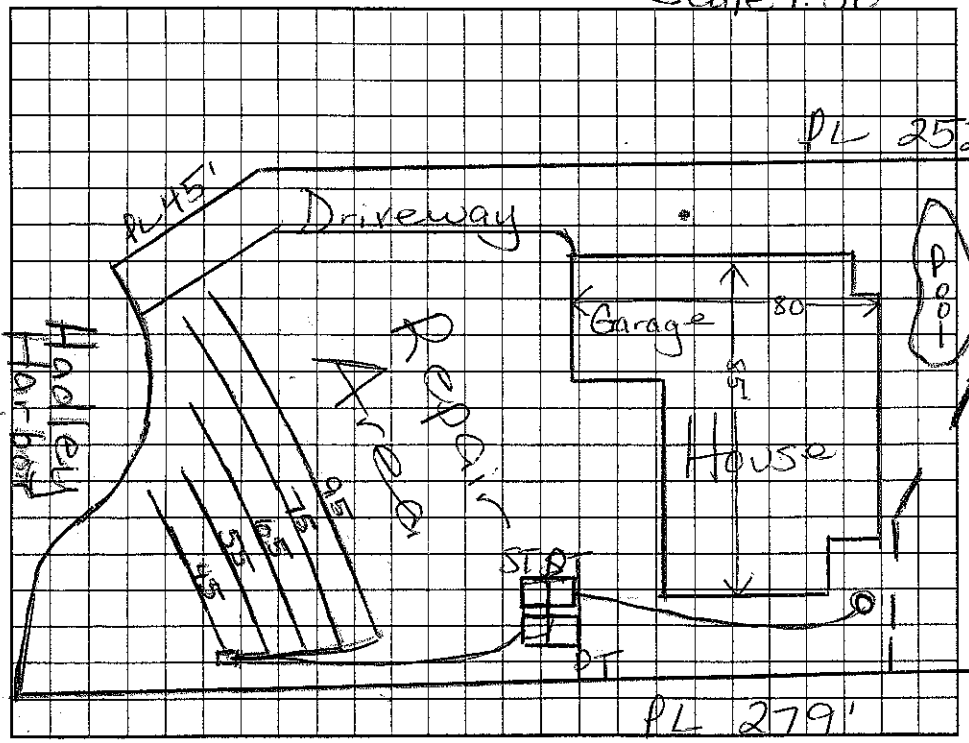

AS BUILT SKETCH

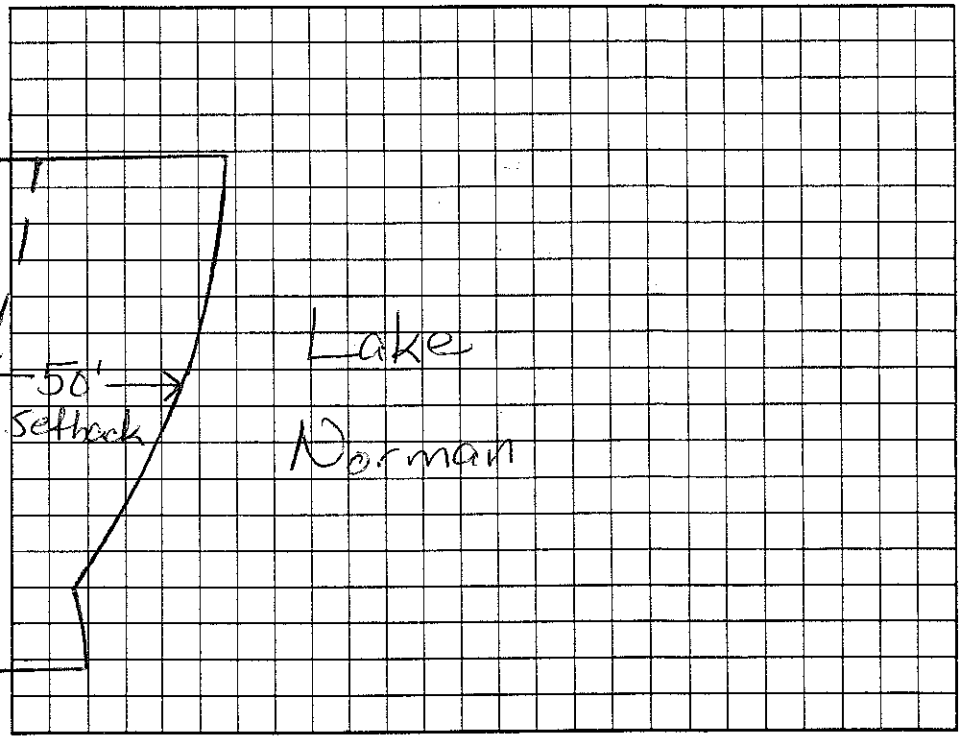

Permit can be suspended or revoked if any false information is supplied toward securing the permit/any unauthorized changes are made to the site/any unauthorized changes are made in the installation of the system. Improvement Permit with plat valid without expiration. Improvement Permit with site plan valid for sixty months. Authorization to Construct is valid for a period equal to that of Improvement Permit – not to exceed sixty months.

Signed: Bill Poplin date 8-13-04
Improvement Permit by: Maria H. Dolson RS date 8/12/04
Authorization to Construct by: Maria H. Dolson RS date 8/12/04

Installed by: R & H date
Operation Permit by: Maria H. Dolson RS date 12/22/04
Existing System Inspection by: date

HEALTH DEPT. COPY: WHITE OWNER COPY (FINAL): YELLOW OWNER COPY (INITIAL): PINK