IREDELL COUNTY HEALTH DEPARTMENT

STATESVILLE 704-878-5305 50.00 Paid MOORESVILLE 704-664-5281

IMPROVEMENT PERMIT / AUTHORIZATION TO CONSTRUCT / OPERATION PERMIT / EXISTING SYSTEM INSPECTION

PERMIT# 127953 PIN# 4625842807 Dan 4635-09-1810 DATE 10-12-05

OWNER OR APPLICANT Arcadia Homes PHONE: Business 201-7181 Home 889-4663

ADDRESS P.O. Box 471941 Charlotte, NC 28247

LOCATION Brawley School Rd II Brawley Harbor on left

SUBDIVISION Point BLOCK / SECTION II LOT 26 LOT AREA 43,673 ft2 SITE CLASS. PS DESIGN FLOW 600 L.T.A.R. .3

Septic Tank 1500 Gallons; STB 3.38 Date 10-21-05 ☒ New System ☐ Repair ☐ Expansion System Type: I II III IV V VI

Pump Tank 1500 Gallons; PT 4.97 Date 12-26-05 System Description: Pump-LP-Panel Block

Pump Make: Goulds Model VEC3121HD Serial No. Repair System Description: Same

Nitrification Field: No Fields 1 Square Feet 1008' Linear Feet 336' Maintenance Agreement Required: ☒ Yes ☐ No

No Lines 30 12' Trench Width 34"-36" Max Trench Bottom Depth 36' Gravel Depth N/A ☐ Gravity ☒ Pressure

☒ House/Mod. Home ☐ Mobile Home ☐ Business ☐ Other

No. Bedrooms 5 No. Persons ___ No. Employees ___


Water Supply: ☐ Individual ☒ Public ☒ Community

☐ Slab ☐ Crawl Space ☒ Basement w/plumbing ☐ Basement wo/plumbing

Comments:/Conditions:

Scale 1:50'

INITIAL SITE SKETCH

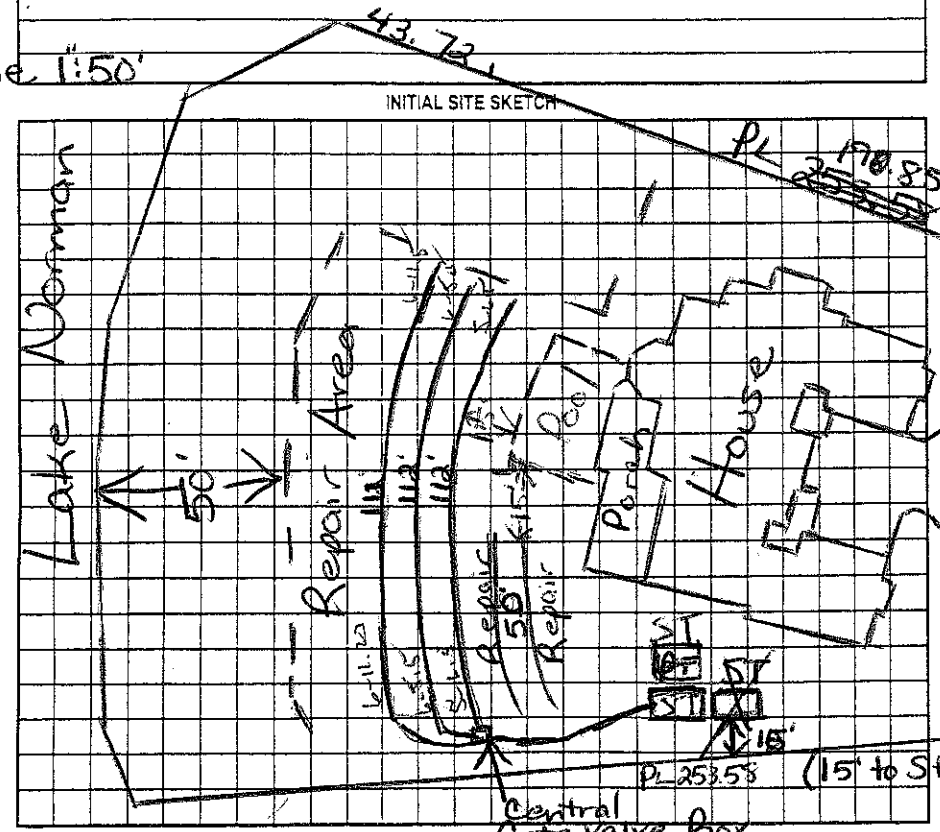

Comments:/Conditions: ☒ Must keep pool "cut" 15ft From Septic System (Initial & repair) ☒ Okay to center feed drainlines but keep supply line out of repair area.

AS BUILT SKETCH

12/26/05 - Drainfield Tanks Checked 2/10/06

Pressure, float & alarm 6/21/06

Permit can be suspended or revoked if any false information is supplied toward securing the permit/any unauthorized changes are made to the site/any unauthorized changes are made in the installation of the system. Improvement Permit with plat valid without expiration ☐ Improvement Permit with site plan valid for sixty months ☐ Authorization to Construct is valid for a period equal to that of Improvement Permit – not to exceed sixty months.

Signed: Debra A. Thomas date 10/18/05 Installed by: R+H

Improvement Permit by: Maria H. Dobson RS date 10/13/05 Operation Permit by: Maria H. Dobson RS date 6/21/06

Authorization to Construct by: Maria H. Dobson RS date 10/13/05 Existing System Inspection by: ___ date ___

HEALTH DEPT. COPY: WHITE OWNER COPY (FINAL): YELLOW OWNER COPY (INITIAL): PINK