IREDELL COUNTY HEALTH DEPARTMENT

STATESVILLE 704-878-5305 MOORESVILLE 704-664-5281

* As Built Drawing

IMPROVEMENT PERMIT / AUTHORIZATION TO CONSTRUCT / OPERATION PERMIT / EXISTING SYSTEM INSPECTION

PERMIT# 078219 PIN# 4625842807 Rick 4635-09-2657 DATE 1-10-03

OWNER OR CONTRACTOR Simonini Builders LCRI PHONE: Business 201-8976 Home

ADDRESS 817 E. Morehead Charlotte NC 28202

LOCATION Brawley School Rd TL Brawley Harbor Place on left

SUBDIVISION The Point BLOCK / SECTION II LOT 259 LOT AREA 42531 SITE CLASS PS DESIGN FLOW 480gpd L.T.A.R. ~.25

Septic Tank: 1500 Gallons; STB 338 Date 11-18-02

Pump Tank: Gallons; PT Date

Pump Make: Model Serial No.

Nitrification Field: No Fields 1 Square Feet 1440 Linear Feet 480'

No Lines 6 Trench Width 36" Max Trench Bottom Depth 36" Gravel Depth N/A

☒ New System ☐ Repair System Type: I, II, III, IV, V, VI

System Description: Gravity -25% Reduction

Repair System Description: Pump-Panel Blk

Maintenance Agreement Required: ☐ Yes ☒ No

☒ House/Mod. Home No. Bedrooms 4

☐ Mobile Home No. Bathrooms 4

☐ Business No. Employees

☐ Other

☐ Slab ☐ Crawl Space ☒ Basement w/plumbing ☐ Basement wo/plumbing


Water Supply: ☐ Individual ☒ Public ☒ Community

Comments/Conditions:


Comments/Conditions:

Scale 1:40

INITIAL SITE SKETCH

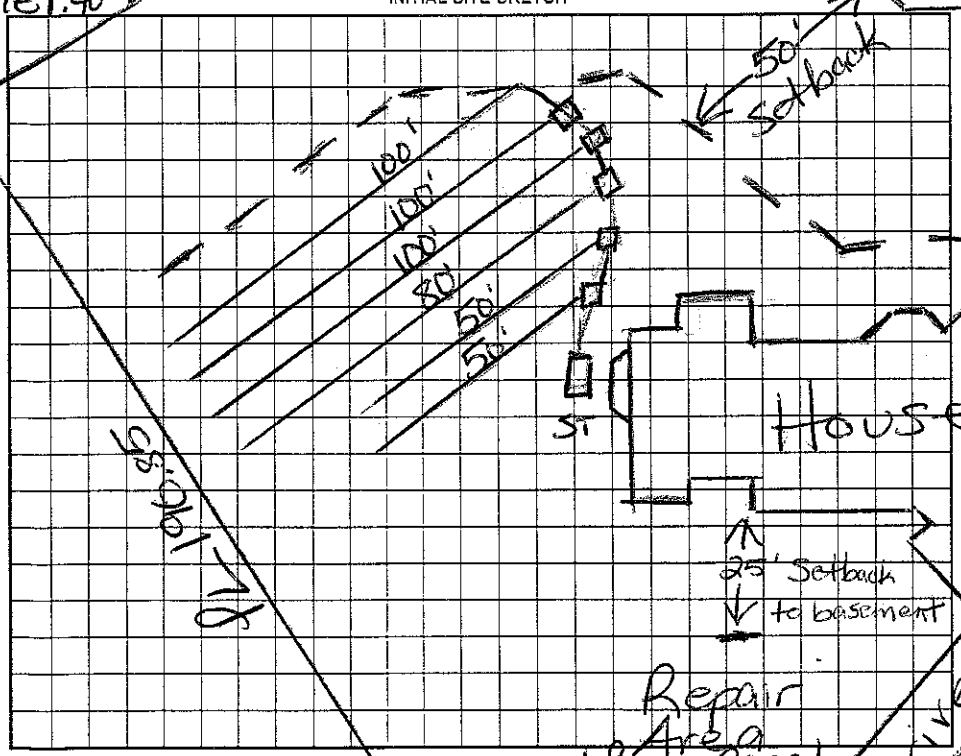

AS BUILT SKETCH

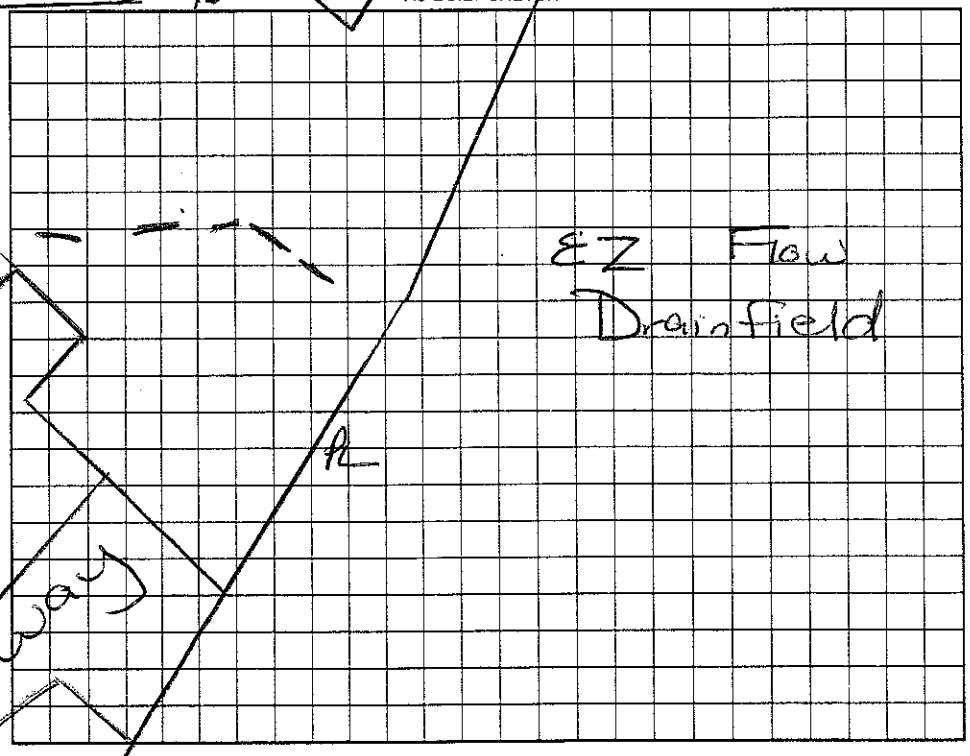

Permit can be suspended or revoked if any false information is supplied toward securing the permit, any unauthorized changes are made to the site, any unauthorized changes are made in the installation of the system. Improvement Permit with plat valid without expiration. Improvement Permit with site plan valid for sixty months. Authorization to Construct is valid for a period equal to that of Improvement Permit – not to exceed sixty months.

Signed: date Installed by: R & H Inc

Improvement Permit by: date Operation Permit by: Mark H Dotson RS date 1/10/2003

Authorization to Construct by: date Existing System Inspection by: date

HEALTH DEPT. COPY: WHITE OWNER COPY (FINAL): YELLOW OWNER COPY (INITIAL): PINK