IREDELL COUNTY HEALTH DEPARTMENT

STATESVILLE 704-878-5305 MOORESVILLE 704-664-5281

IMPROVEMENT PERMIT / AUTHORIZATION TO CONSTRUCT / OPERATION PERMIT / EXISTING SYSTEM INSPECTION

PERMIT# 078217 PIN# ~~4625842807 (pt)~~ 4635094169 DATE May 30, 2000

OWNER OR CONTRACTOR Simonini Builders PHONE: Business 358-9940 Home

ADDRESS 817 E. Morehead St. Suite 100 Charlotte 28202-2705

LOCATION Brawley Sch. Rd. TL Brawley Harbor Place on left NEAR END

SUBDIVISION The Point BLOCK / SECTION II LOT 255 LOT AREA 41,726 ft² SITE CLASS. RS DESIGN FLOW 600 gpd L.T.A.R. ~.3

Septic Tank: 1500 Gallons; STB 338 Date 12-26-00
Pump Tank: 1500 Gallons; PT [illegible] Date 12-4-00
Pump Make: MYERS Model ME50S 21 Serial No.
Nitrification Field: No Fields 1 Square Ft. 1590 Linear Feet ~~1400~~ 530
No Lines 4@134' Trench Width 36" Max Trench Bottom Depth 36" Gravel Depth N/A

☑ New System ☐ Repair System Type: I, II, III, IV, V, VI
System Description: PM-INNOVATIVE -25% Red.
Repair System Description: LP. INNOVATIVE // Panel B/K
Maintenance Agreement Required: ☐ Yes ☑ No


☑ House/Mod. Home No. Bedrooms 5
☐ Mobile Home No. Bathrooms 5
☐ Business No. Employees
☐ Other
☐ Slab ☐ Crawl Space ☑ Basement w/plumbing ☐ Basement wo/plumbing

Water Supply: ☐ Individual ☐ Public ☐ Community


Comments:/Conditions: ① ONE INSPECTION PORT PER LATERAL. This replaces permit issued 3-24-99 to CRI.

Comments:/Conditions: Checked tanks & lines 2/2/2001 MP
EZ Lay / EZ Flow installed

INITIAL SITE SKETCH

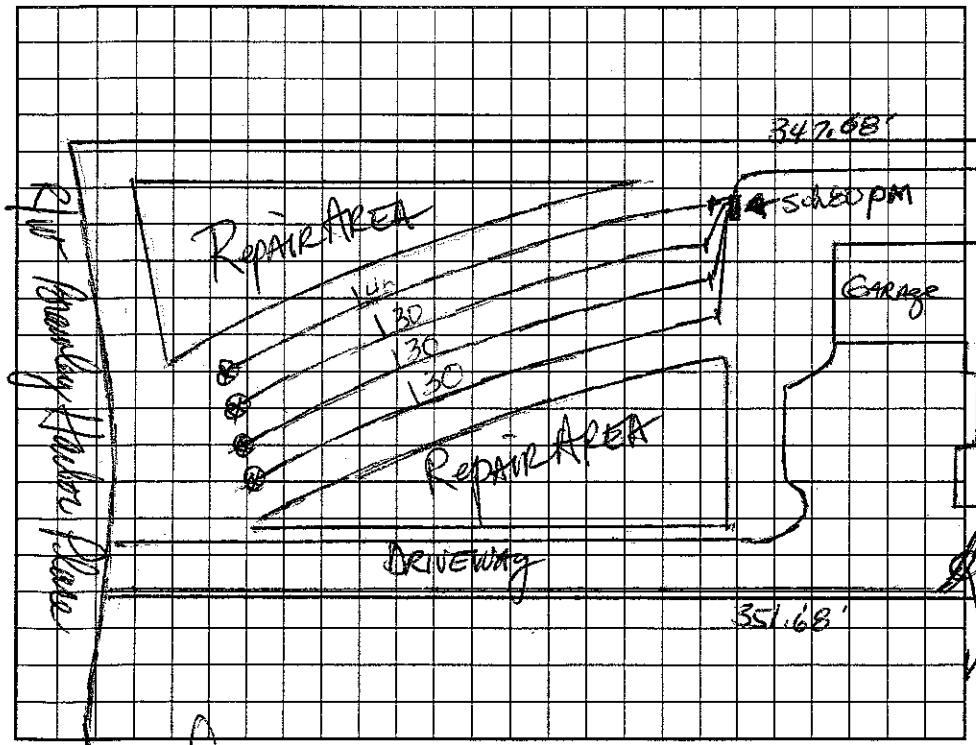

AS BUILT SKETCH

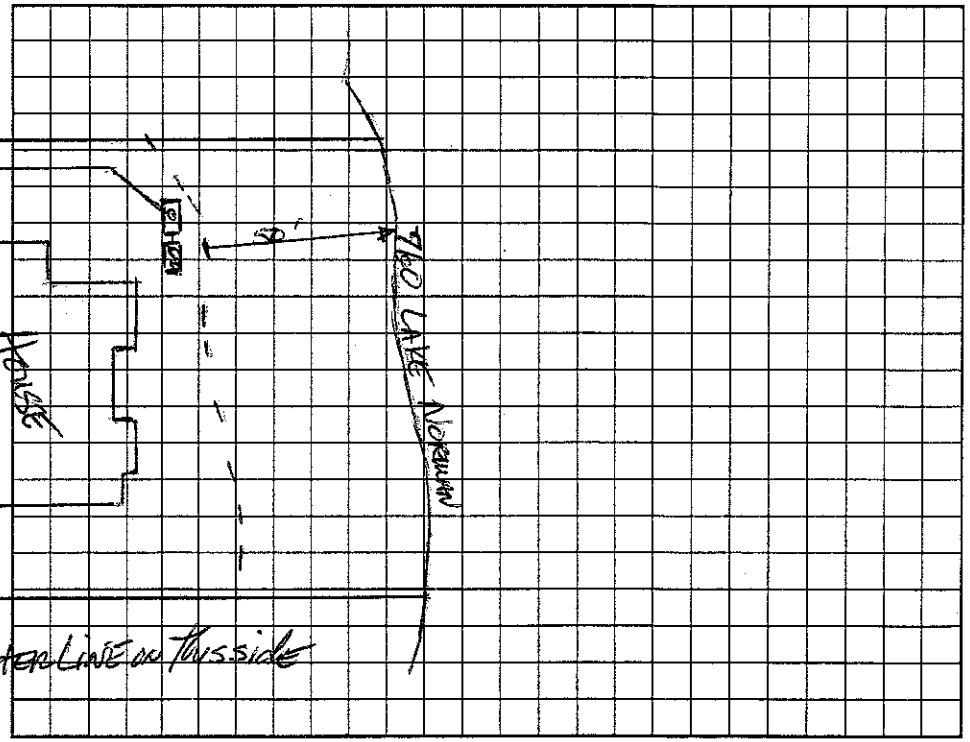

Permit can be suspended or revoked if any false information is supplied toward securing the permit/any unauthorized changes are made to the site/any unauthorized changes are made in the installation of the system. Improvement Permit with plat valid without expiration; Improvement Permit with site plan valid for sixty months. Authorization to Construct is valid for a period equal to that of Improvement Permit – not to exceed sixty months.

Signed: [signature] date 6/2/00 Installed by: R & H Inc.

Improvement Permit by: [signature], RS date 5-30-2000 Operation Permit by: Wesley Sparks RS. date 4/19/01

Authorization to Construct by: [signature], RS date 5-30-2000 Existing System Inspection by: date

HEALTH DEPT. COPY: WHITE OWNER COPY (FINAL): YELLOW OWNER COPY (INITIAL): PINK