IREDELL COUNTY HEALTH DEPARTMENT

STATESVILLE 704-878-5305 245.00 Pd 3.00 MOORESVILLE 704-664-5281

IMPROVEMENT PERMIT / AUTHORIZATION TO CONSTRUCT / OPERATION PERMIT / EXISTING SYSTEM INSPECTION

PERMIT# 078216 PIN# ~~4625842807 pt~~ 4635-09-4301 DATE 3-18-2003

OWNER OR CONTRACTOR CRI / Simonini PHONE: Business (704) 358-9940 Home Ron 309-3271

ADDRESS 817 E / Morehead Charlotte, NC 28202

LOCATION Brawley School Rd TL Brawley Harbour Place near end on left

SUBDIVISION The Point BLOCK / SECTION II LOT 256 LOT AREA 41,037 ft² SITE CLASS. PS DESIGN FLOW 600gpd L.T.A.R. .3

Septic Tank: 1500 Gallons; STB 338 Date 10-13-03
Pump Tank: 1500 Gallons; PT Date
Pump Make: Myers Model ME505 Serial No. 2535710
Nitrification Field: No. Fields 1 Square Feet 1071 Linear Feet 357
No Lines 5 Trench Width 24"-36" Max Trench Bottom Depth 30" Gravel Depth N/A

☒ New System ☐ Repair System Type: I II III IV V VI
System Description: Pump-LP-Panel Blk
Repair System Description: Pump-LP-25% Reduction
Maintenance Agreement Required: ☒ Yes ☐ No


☒ House/Mod. Home ☐ Mobile Home ☐ Business ☐ Other
No. Bedrooms 5 No. Bathrooms 6 No. Employees
☐ Slab ☐ Crawl Space ☒ Basement w/plumbing ☐ Basement wo/plumbing

Water Supply: ☐ Individual ☒ Public ☒ Community


Comments:/Conditions: Scale 1:60'
Keep Septic System at least 10' From PL & 50' From Lake

Comments:/Conditions: Note: Permit draw as per plan Submitted by Toney Jacobs & Assoc. on 3/18/03.
10/14/03 Checked 4 of 5 lines Checked 5th line 10/17/03
Checked tanks 11/4/03

INITIAL SITE SKETCH

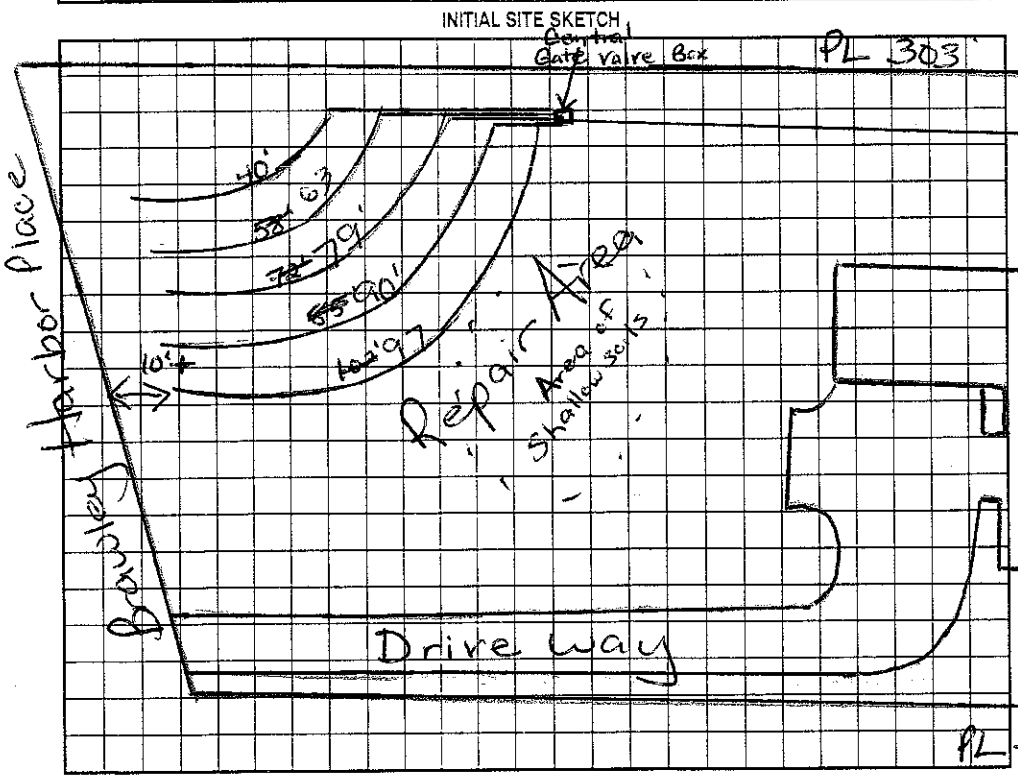

AS BUILT SKETCH

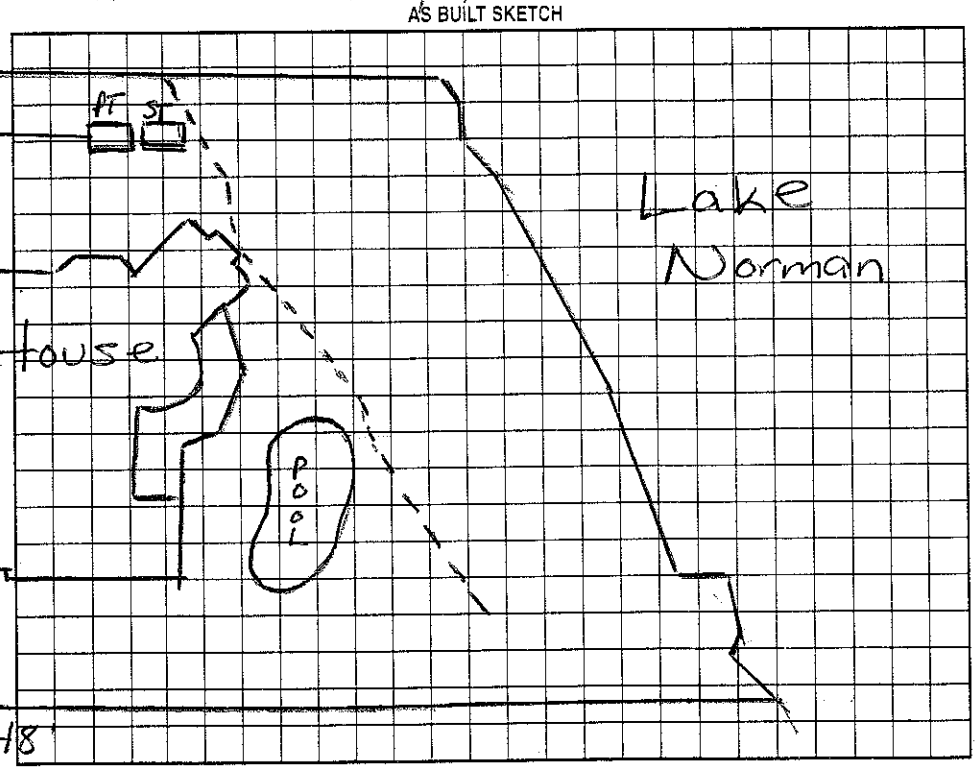

Permit can be suspended or revoked if any false information is supplied toward securing the permit/any unauthorized changes are made to the site/any unauthorized changes are made in the installation of the system. Improvement Permit with plat valid without expiration. Improvement Permit with site plan valid for sixty months. Authorization to Construct is valid for a period equal to that of Improvement Permit – not to exceed sixty months.

Signed: Ron Miller date 3-19-03 Installed by: R&H

Improvement Permit by: Maria H. Dotson RS date 3/19/03 Operation Permit by: Maria H. Dotson RS date 4/27/04

Authorization to Construct by: Maria H. Dotson RS date 3/19/03 Existing System Inspection by: date

HEALTH DEPT. COPY: WHITE OWNER COPY (FINAL): YELLOW OWNER COPY (INITIAL): PINK