IREDELL COUNTY HEALTH DEPARTMENT

STATESVILLE 704-878-5305 MOORESVILLE 704-664-5281

IMPROVEMENT PERMIT / CERTIFICATE OF COMPLETION / OPERATION PERMIT / EXISTING SYSTEM INSPECTION

PROPERTY DESCRIPTION NO. 21107 DATE 6/13/95 TAX MAP NO. 26 23 B 16 Watershed: ☒ Yes ☐ No

OWNER OR CONTRACTOR Robert Ringrose Homes PHONE: Business 391-3715 ~~Home~~ 4635-09-9819

ADDRESS 2900 E I 85 Service Rd. Charlotte, NC 28208

LOCATION Brawley Sch. TL Lake Pines, TR Cove Creek TL Wynnewood TL Wynnewood, At end on cul de sac

SUBDIVISION Northshire BLOCK / SECTION 1 LOT 16 LOT AREA ~1.6 Ac. SITE CLASS. P DESIGN FLOW 480 L.T.A.R. .3

Septic Tank: 1000 Gallons; STB 825 Date 7/26/95

Pump Tank: _____ Gallons; PT _____ Date _____

Pump Make: _____ Model _____ Serial No. _____

Nitrification Field: No Fields 1 Square Feet 1600 Linear Feet ~~267~~ 533

No Lines 4 Trench Width 24" Max Trench Bottom Depth 36" Gravel Depth 6" STONE

☒ New System ☐ Repair System Type: I, II, (III), IV, V, VI

System Description: CONV. PANEL

Repair System Description: SAME

Maintenance Agreement Required: ☐ Yes ☒ No

☒ House/Mod. Home No. Bedrooms 4

☐ Mobile Home No. Bathrooms 3.5

☐ Business No. Employees _____

☐ Other _____


☐ Slab ☒ Crawl Space ☐ Basement w/plumbing ☐ Basement wo/plumbing

Water Supply: ☐ Individual ☒ Community ☐ Public


Comments:

Comments: 65 / 4 / 260

INITIAL SITE SKETCH

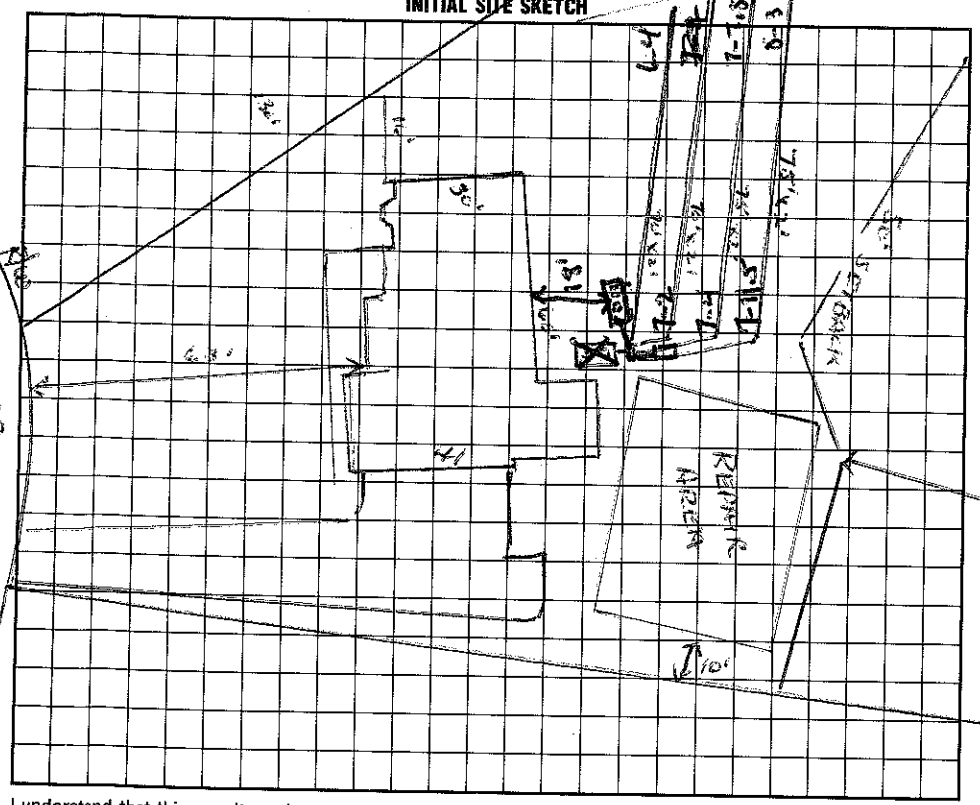

AS BUILT SKETCH

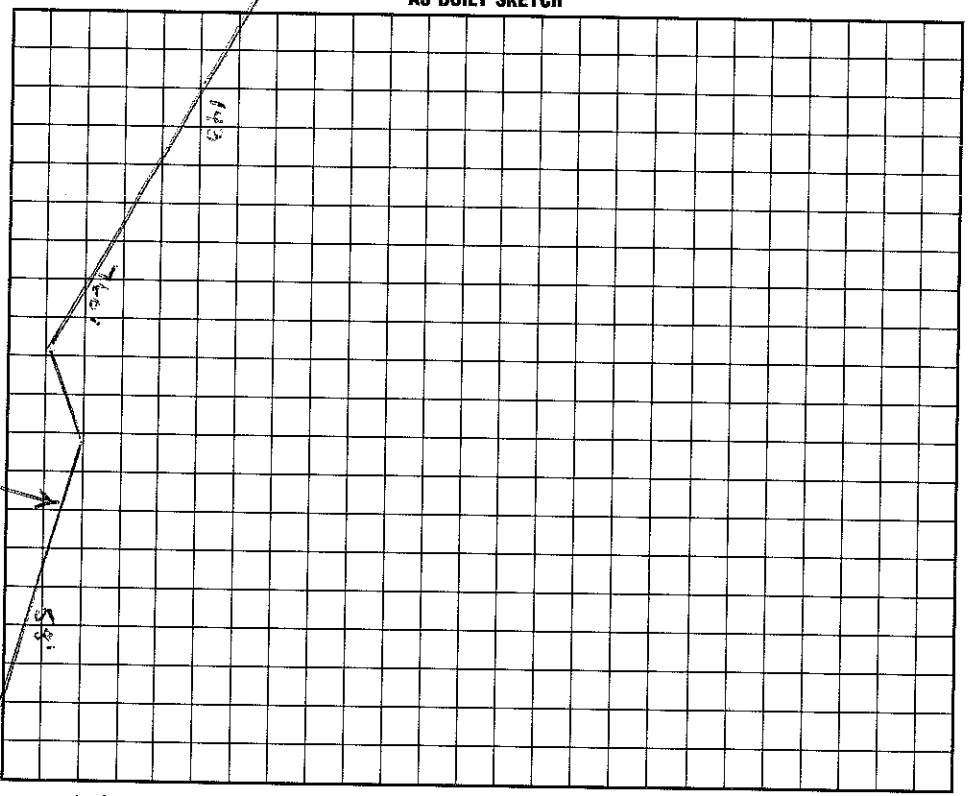

I understand that this permit can be suspended or revoked if any false information is supplied toward securing the permit/any unauthorized changes are made to the site/any unauthorized changes are made in the installation of the system. Improvement Permit is valid for 60 months from date of issuance.

Signed: _____ 6-13-95

Improvement Permit by: Wesley Sparks R.S. date 6/13/95

Existing System Inspection by: _____ date _____

Installed by: Elson Hayes Grading

Certificate of Completion by: Wesley Sparks R.S. date 8/25/95

Operation Permit by: _____ date _____

HEALTH DEPT. COPY: WHITE INSPECTION COPY (FINAL): GREEN OWNER COPY (FINAL): YELLOW INSPECTION COPY (INITIAL): PINK OWNER COPY (INITIAL): GOLD