EDELL COUNTY HEALTH DEPARTMENT

E : 704-878-5305 MOORESVILLE 704-664-5281

IMPROVEMENT PERMIT / AUTHORIZATION TO CONSTRUCT , OPERATION PERMIT / EXISTING SYSTEM INSPECTION

PERMIT# 07761 PIN# 4625941684 4635121849

OWNER OR CONTRACTOR Crescent Resources clo. / Dienst PHONE: Business Home DATE Aug. 5, '98

ADDRESS P.O. Box 1003, Charlotte

LOCATION Brawley Sch Rd. TL The Pointe Dr. Queen Anne Circle to Vineyard Dr. to Falmouth Rd. on Right

SUBDIVISION The Pointe BLOCK / SECTION 1A LOT 77 LOT AREA 36,992 Ft² SITE CLASS RS DESIGN FLOW 440 gpd L.T.A.R. .3

Septic Tank: 1000 Gallons; STB 338 Date 7-4-04

Pump Tank: 1000 Gallons; PT 27 Date 5-29-04

Pump Make: Myers Model ME50 Serial No.

Nitrification Field: No. Fields 1 Square Feet 1200 Linear Feet 400

No Lines 3@134 Trench Width 36" Max Trench Bottom Depth 36" Gravel Depth NA

☑ New System ☐ Repair System Type: I, II, III, IV, V, VI

System Description: pumped-pm-25% Reduction

Repair System Description: Same

Maintenance Agreement Required: ☐ Yes ☑ No

☑ House/Mod. Home No. Bedrooms 4

☐ Mobile Home No. Bathrooms 4

☐ Business No. Employees

☐ Other


☐ Slab ☑ Crawl Space ☐ Basement w/plumbing ☐ Basement wo/plumbing

Water Supply: ☐ Individual ☑ Public ☑ Community


Comments:/Conditions: * ONE INSPECTION/OBSERVATION PORT PER LATERAL
Remove any old Berms / Terraces

Comments:/Conditions: Tanks & lines, 8/10/04
Checked pres, elect & alarm 10/4/04
Auto Dialer & alarm floats need to be Switched

INITIAL SITE SKETCH 1"=50'

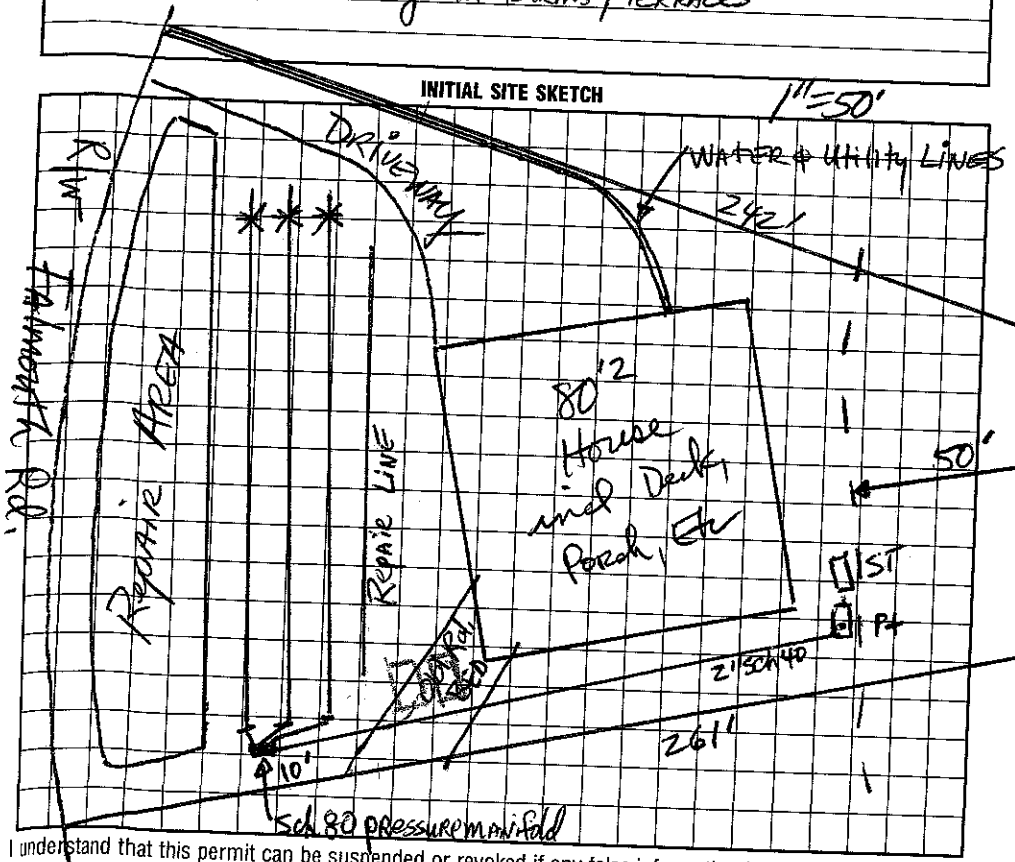

AS BUILT SKETCH

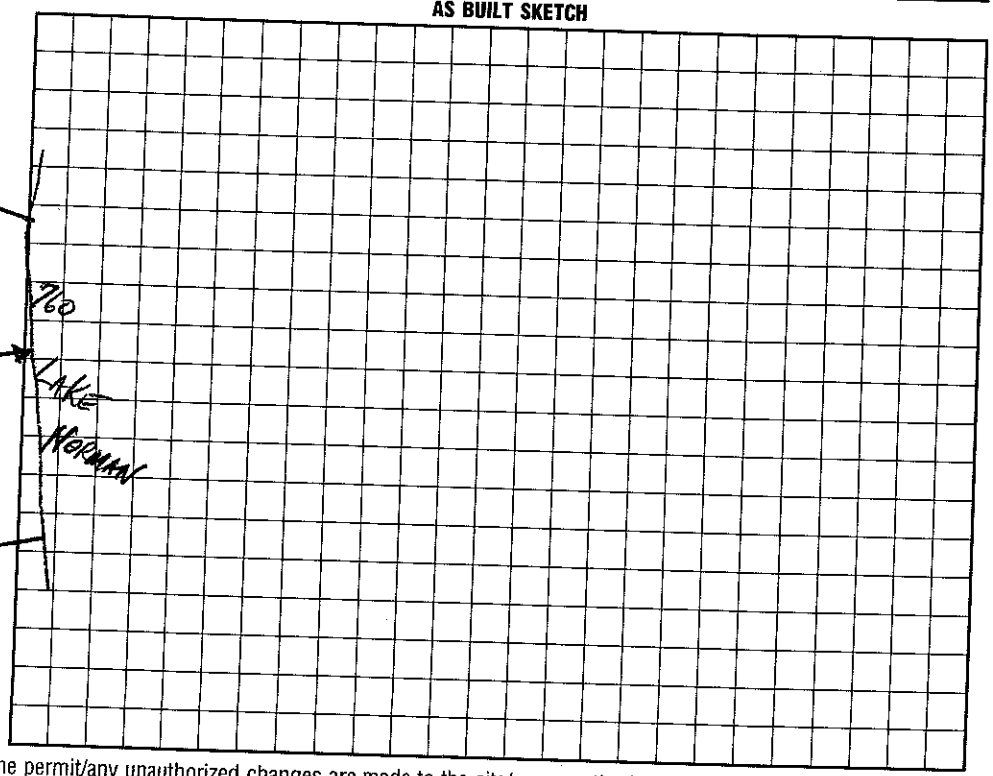

I understand that this permit can be suspended or revoked if any false information is supplied toward securing the permit/any unauthorized changes are made to the site/any unauthorized changes are made in the installation of the system. Improvement Permit with plat valid without expiration. Improvement Permit with site plan valid for sixty months. Authorization to Construct is valid for a period equal to that of Improvement Permit – not to exceed sixty months.

Signed:

Improvement Permit by: date 8-20-98

Authorization to Construct by: RS date 8-5-98

Installed by: R & H RS

Operation Permit by: date 1/22/04

Existing System Inspection by:

HEALTH DEPT. COPY: WHITE INSPECTION COPY (FINAL): GREEN OWNER COPY (FINAL): YELLOW INSPECTION COPY (INITIAL)