IREDELL COUNTY HEALTH DEPARTMENT

STATESVILLE 704-878-5305 MOORESVILLE 704-664-5281

IMPROVEMENT PERMIT / AUTHORIZATION TO CONSTRUCT / OPERATION PERMIT / EXISTING SYSTEM INSPECTION

PERMIT # 157395 PIN # 4635-12-2737 DATE 7-10-09

OWNER or APPLICANT SALVATORB ZAMITTI/CourtlandProp PHONE: Business 704-363-1622 - BUILDER

OWNER or APPLICANT ADDRESS 12 JOHN MATHEWS RD MARYLAND

LOCATION / DIRECTIONS BSR, MEETING ST, TL VINYARD, TL FALMOUTH, ON R

SUBDIVISION THE POINT BLOCK / SECTION 1A LOT # 78 LOT AREA .75AC DESIGN FLOW 600 L.T.A.R. .25

Septic Tank *1500 Gallons: STB 338 Date 2-19-09

Pump Tank *1500 Gallons: PT 511 Date 12-23-08

Pump Make Myers Model ME50 Serial #

Nitrification Field No Fields 1 No Lines 4 Linear Feet 400'

Trench Width 24"-36" Max. Trench Bottom Depth 36" Gravel Depth SAND

☒ New System ☐ Repair ☐ Expansion System Type I II III (IV) V VI

System Description: LP- PANEL BLOCK

Repair System Description: SAME

Maintenance Agreement Required ☒ YES ☐ NO

☒ Residence No. Bedrooms 5

☐ Business No. Persons

☐ Other No. Employees

☐ Slab ☒ Crawl Space


☐ Basement w/plumbing ☐ Basement w/o plumbing

Water Supply: ☐ Private ☐ Public ☒ Community


Comments / Conditions 1) MAINTAIN ALL SETBACKS 2) KEEP CVB ABOVE TOP LINE TO PREVENT BLEED BACK 3) TYPE IV SYSTEM REQUIRES INLINE FILTER IN PUMP TANK

Comments / Conditions 3/10/2010 Checked tanks & lines

INITIAL SITE SKETCH

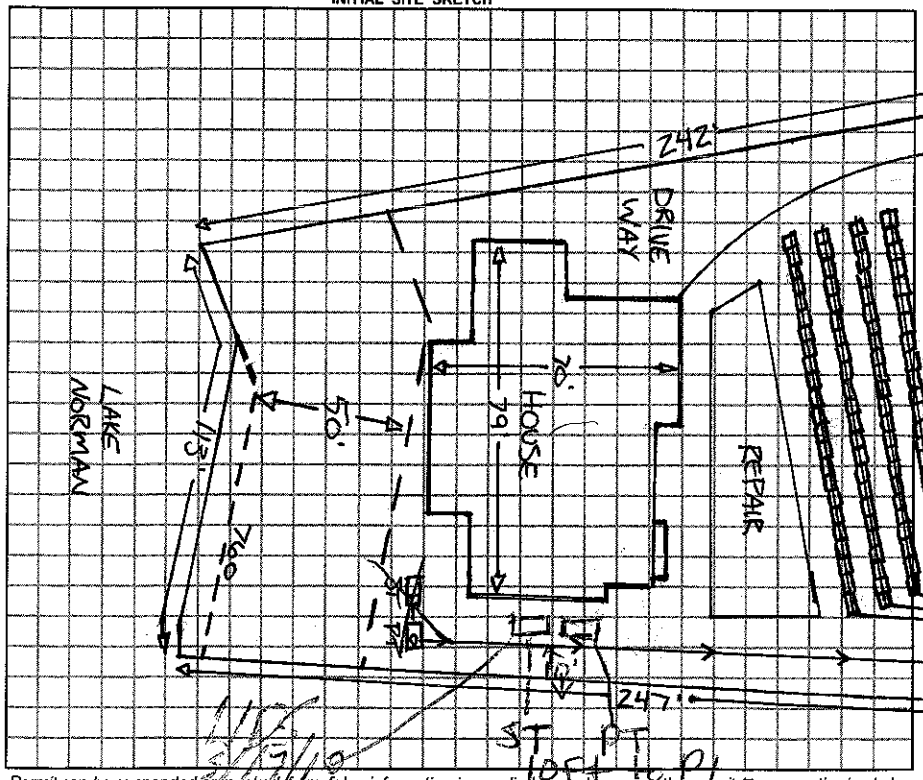

AS BUILT SKETCH

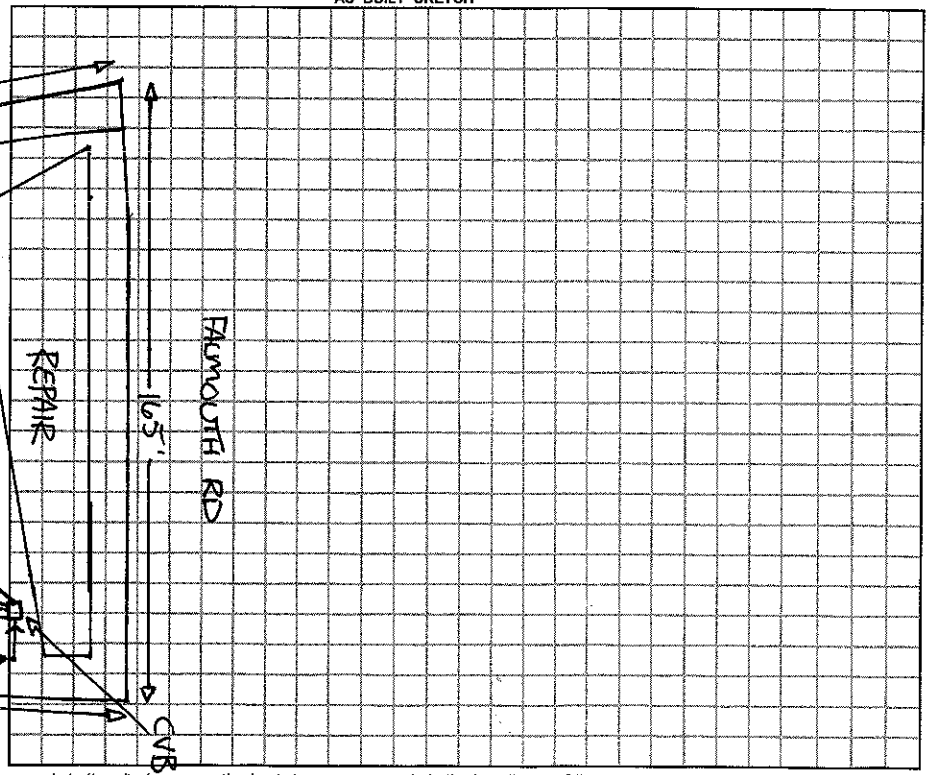

Permit can be suspended or revoked if any false information is supplied toward securing the permit / any unauthorized changes are made to the site / any unauthorized changes are made in the installation of the system.

☐ *IMPROVEMENT PERMIT w / plat valid without expiration.* ☒ *IMPROVEMENT PERMIT w / site plan valid for 60 mos.* ☒ *AUTHORIZATION TO CONSTRUCT valid for period equal to IMPROVEMENT PERMIT-not to exceed 60 mo.*

Owner / Applicant Signature: Date 9-17-09

Improvement Permit by: Date 7-10-09

Authorization to Construct by: Date 9-17-09

Installed by: RS

Operation Permit by: Date: 5/17/2010

Existing System Inspected by: Date:

YOU SHOULD CONTACT A LOCATOR SERVICE PRIOR TO ANY EXCAVATION.

WHITE COPY Environmental Health YELLOW COPY (Final) Owner / Applicant PINK COPY (Initial) Owner / Applicant