...NTY HEALTH ...
...EMENT PERMIT / AUTHORIZA... STATESVILLE 704-878-5305 MOORESVILLE 704-664-5281
...CONSTRUCT / OPERATION PERMIT / EXISTING SYSTEM INSPEC...

PERMIT# 97182 PIN# 4625941157 (pt) 4635-12-5272

OWNER OR CONTRACTOR Crescent Resources Inc. / Potter Bld PHONE: Business DATE April 29, 199

ADDRESS PO Box 1903, Charlotte 10720 Campbell Commons Blvd Charlotte Home

LOCATION Brawley Sch Rd. TL The Pointe Dr. Queenienne Circle to Vineyard Dr. to Falmouth Rd to Woodstock Ct.

SUBDIVISION The Point BLOCK / SECTION 1A LOT 87 LOT AREA 39078ft² SITE CLASS. I/S DESIGN FLOW 600gpd L.T.A.R. .3

Septic Tank: 1500 Gallons; STB 338 Date 7-4-99

Pump Tank: 1500 Gallons; PT 27 Date 12-14-99

Pump Make: Myers Model ME35-21 Serial No. 2900

Nitrification Field: No Fields 1 Square Feet 1500 Linear Feet 500

No Lines 5 @ 100' Trench Width 36" Max Trench Bottom Depth 36" Gravel Depth N/A

☑ New System ☐ Repair System Type: I, II, (III) IV, V, VI

System Description: PM - Innovative w/25% Red.

Repair System Description: LL Panel Block

Maintenance Agreement Required: ☐ Yes ☑ No

☑ House/Mod. Home ☐ Mobile Home ☐ Business ☐ Other

No. Bedrooms 5 No. Bathrooms 4 No. Employees


☑ Slab ☐ Crawl Space ☐ Basement w/plumbing ☐ Basement wo/plumbing

Water Supply: ☐ Individual ~~☐ Public~~ ☐ Community


Comments:/Conditions: * ONE INSPECTION PORT PER LATERAL
This permit replaces earlier permit of 88-98.

Comments:/Conditions: Tanks & lines checked 4/24/2000.
~~Needs pressure checked~~.

INITIAL SITE SKETCH 1"=50'

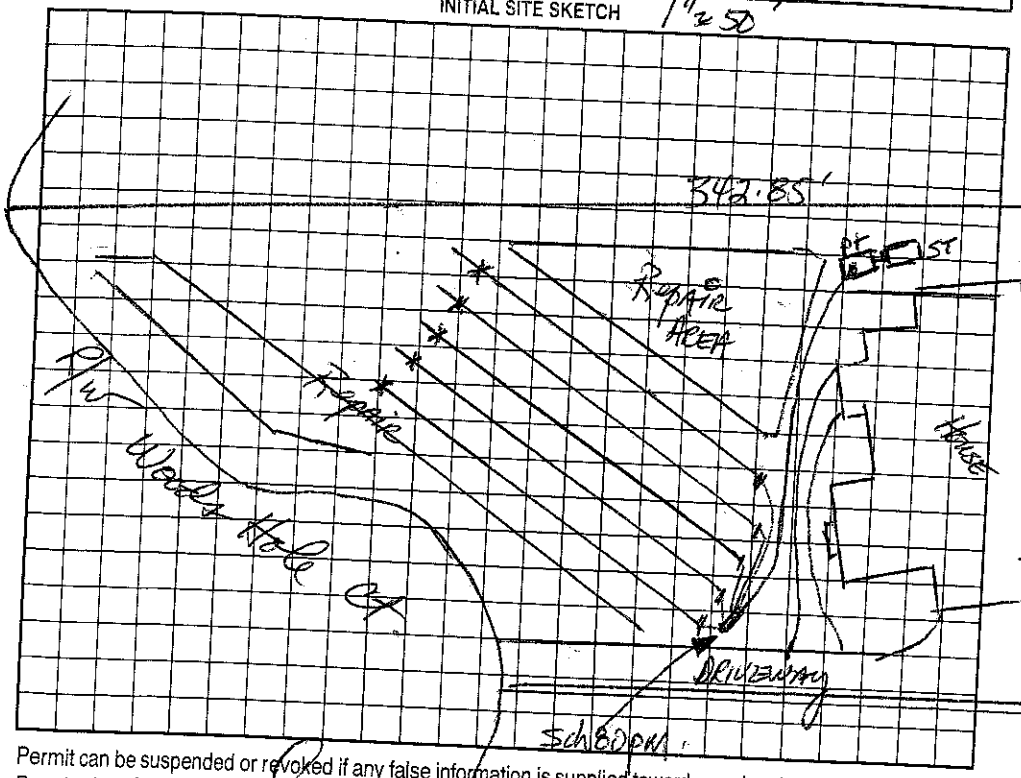

AS BUILT SKETCH

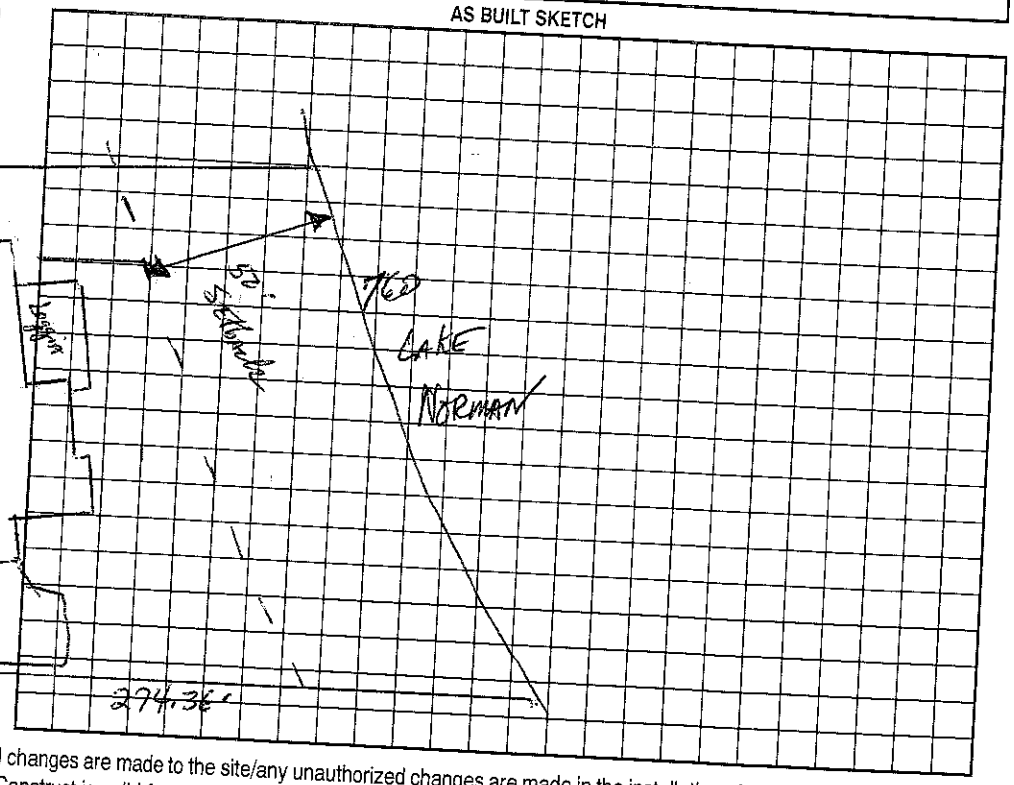

Permit can be suspended or revoked if any false information is supplied toward securing the permit/any unauthorized changes are made to the site/any unauthorized changes are made in the installation of the system. Improvement Permit with plat valid without expiration. Improvement Permit with site plan valid for sixty months. Authorization to Construct is valid for a period equal to that of Improvement Permit – not to exceed sixty months.

Signed: _____ date _____

Improvement Permit by: _____ date 4-29-99

Authorization to Construct by: _____ date 4-29-99

Installed by: Mayhew Septic

Operation Permit by: _____ R.S. date _____

Existing System Inspection by: _____

HEALTH DEPT. COPY: WHITE OWNER COPY (FINAL): YELLOW OWNER COPY (INITIAL): PINK