IREDELL COUNTY HEALTH DEPARTMENT

STATESVILLE 704-878-5305 MOORESVILLE 704-664-5281

IMPROVEMENT PERMIT / AUTHORIZATION TO CONSTRUCT / OPERATION PERMIT / EXISTING SYSTEM INSPECTION

~~420~~ (330)

PERMIT# 072840 PIN# 4625944684 4635-12-5965 DATE July 30, 98

OWNER OR CONTRACTOR Crescent Resources Inc. / John R. Poore Bldr PHONE: Business _____ Home _____

ADDRESS PO Box 1003, Charlotte N.C. 28201

LOCATION Brawley Sch Rd. to The Pointe Dr. Queen Anne Circle to Easton Rd to Old Post Rd to Falmouth Rd to Essex Ct.

SUBDIVISION The Pointe BLOCK / SECTION 1A LOT 34 LOT AREA 40,338 ft² SITE CLASS. PS DESIGN FLOW 480gpd L.T.A.R. .03

Septic Tank: 1000 Gallons; STB 338 Date 7/3/99
Pump Tank: _____ Gallons; PT _____ Date _____
Pump Make: _____ Model _____ Serial No. _____
Nitrification Field: No Fields 1 Square Feet 1200 Linear Feet 488
No Lines 5@80' Trench Width 36" Max Trench Bottom Depth 36"

☑ New System ☐ Repair System Type: I, II, (III) IV, V, VI
System Description: Gravity 25% Reduction
Repair System Description: Gravity/pumped 25% Reduction
Maintenance Agreement Required: ☐ Yes ☑ No
Gravel Depth N/A

☑ House/Mod. Home No. Bedrooms 4/4
☐ Mobile Home No. Bathrooms 4
☐ Business No. Employees _____
☐ Other _____
☐ Slab ☑ Crawl Space ☐ Basement w/plumbing ☐ Basement wo/plumbing


Water Supply: ☐ Individual ☑ Public ☐ Community

Comments:/Conditions: * ONE INSPECTION/OBSERVATION PORT PER LATERAL. Remove old Berms/ TERRACES


Comments:/Conditions: 5-14-99 Reviewed site and revised house plan - now appears in compliance w/ I.P.

1"=50'

INITIAL SITE SKETCH

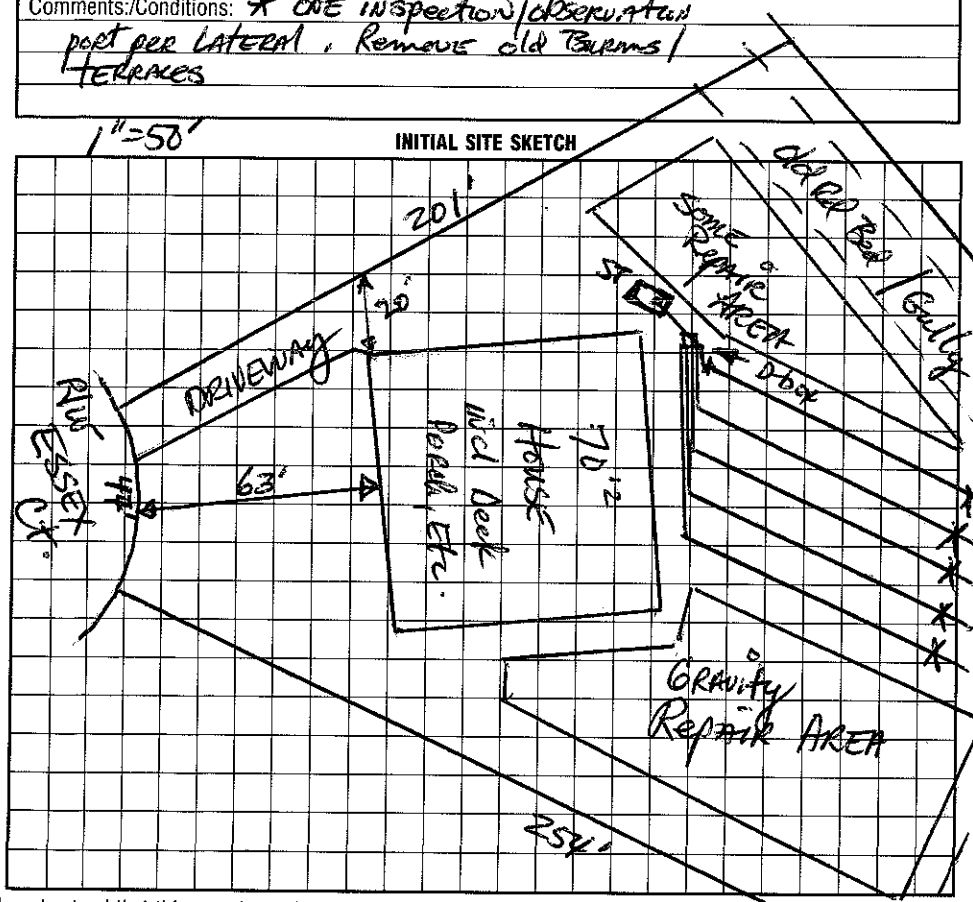

AS BUILT SKETCH

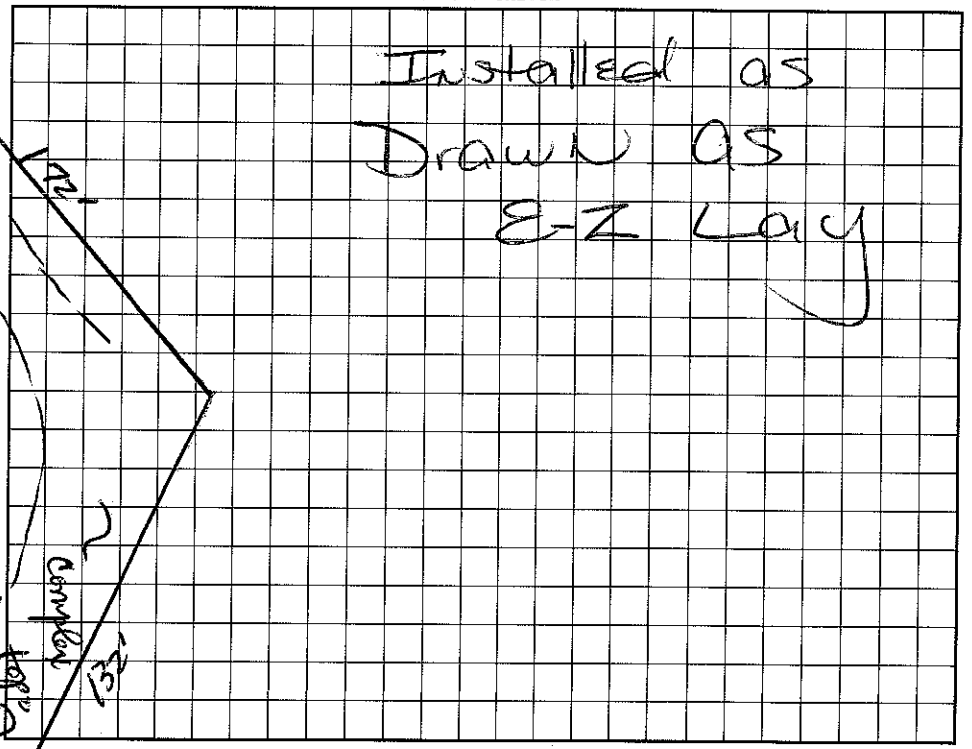

I understand that this permit can be suspended or revoked if any false information is supplied toward securing the permit/any unauthorized changes are made to the site/any unauthorized changes are made in the installation of the system. Improvement Permit with plat valid without expiration. Improvement Permit with site plan valid for sixty months. Authorization to Construct is valid for a period equal to that of Improvement Permit – not to exceed sixty months.

Signed: Ford G. Potts date 8-20-98 Installed by: Stanley Septic

Improvement Permit by: Laura R. Truman, IRS date 7-30-98 Operation Permit by: Maura A. Hall, REHS date R.S. 2/24/2000

Authorization to Construct by: LR Truman IRS date 5-14-99 Existing System Inspection by: _____ date _____

HEALTH DEPT. COPY: WHITE INSPECTION COPY (FINAL): GREEN OWNER COPY (FINAL): YELLOW INSPECTION COPY (INITIAL): PINK OWNER COPY (INITIAL): GOLD