IREDELL COUNTY HEALTH DEPARTMENT

STATESVILLE 704-878-5305 50.00 Paid MOORESVILLE 704-664-5281 3100

IMPROVEMENT PERMIT / AUTHORIZATION TO CONSTRUCT / OPERATION PERMIT / EXISTING SYSTEM INSPECTION

PERMIT# 119898 PIN# 4635-12-7265 DATE 4/16/04

OWNER OR CONTRACTOR Sink Const. / Paul Brayton PHONE: Business 336-787-4184 Home

ADDRESS 4193 old Hwy 64 W Lexington NC 27295

LOCATION BSR, To Point Dr, TL Meeting House, TL Vineyard, TL Falmouth, on Rt past Woods Hole

SUBDIVISION Point BLOCK / SECTION 1A LOT 85/86 LOT AREA 1.65 AC SITE CLASS. PS DESIGN FLOW 720 L.T.A.R. 0.3

Septic Tank: 1500 Gallons; STB Existing Date

Pump Tank: 1500 Gallons; PT Existing Date

Pump Make: Model Serial No.

Nitrification Field: No Fields 1 Square Feet 300 Add Linear Feet* 100' Add

No Lines 1 Trench Width 36" Max Trench Bottom Depth 36" Gravel Depth —

☐ New System ☐ Repair System Type: I, II, III, IV, V, VI

System Description: PM 25% Reduction

Repair System Description: LP Panel Block

Maintenance Agreement Required: ☐ Yes ☒ No

☒ House/Mod. Home No. Bedrooms * 6

☐ Mobile Home No. Bathrooms

☐ Business No. Employees

☐ Other


☐ Slab ☒ Crawl Space ☐ Basement w/plumbing ☐ Basement wo/plumbing

Water Supply: ☐ Individual ☐ Public ☒ Community


Comments:/Conditions:

Comments:/Conditions: * 1 New Bedroom - 6 Total Bedrooms
Total - 600' 25% Reduction
Original Permit in 2001

INITIAL SITE SKETCH

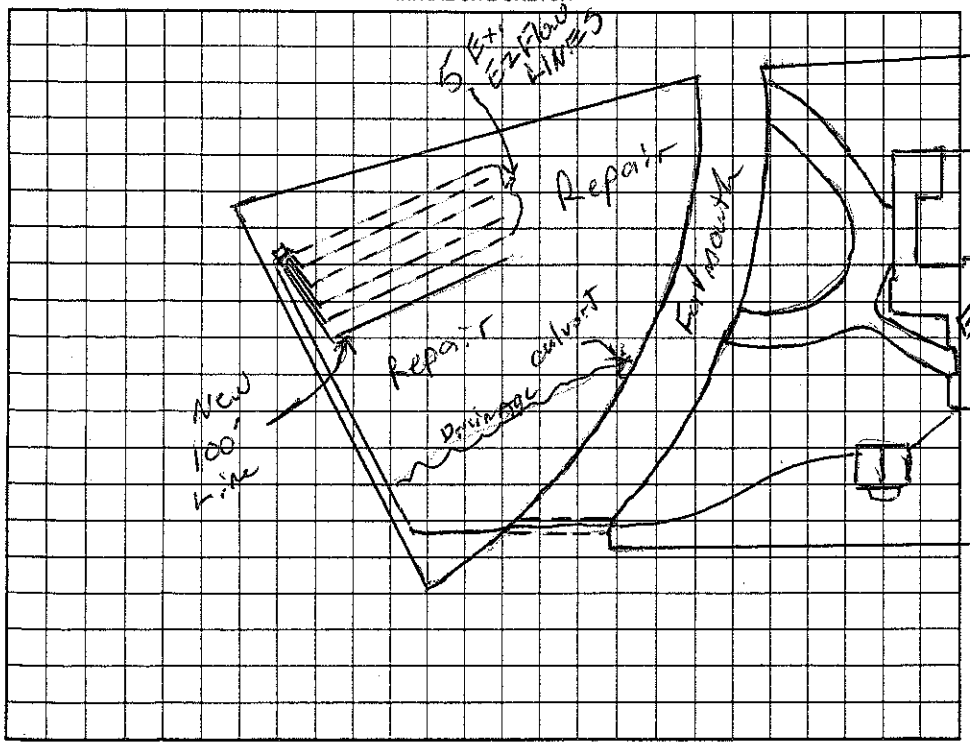

AS BUILT SKETCH

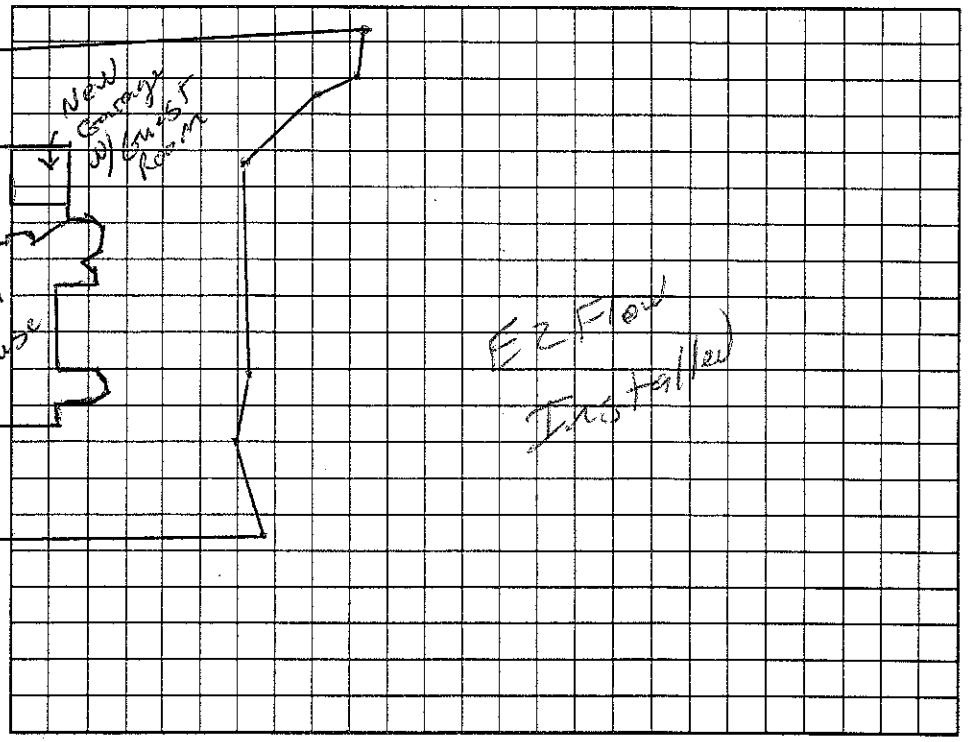

Permit can be suspended or revoked if any false information is supplied toward securing the permit/any unauthorized changes are made to the site/any unauthorized changes are made in the installation of the system. Improvement Permit with plat valid without expiration; Improvement Permit with site plan valid for sixty months. Authorization to Construct is valid for a period equal to that of Improvement Permit – not to exceed sixty months.

Signed: date 4-16-04 Installed by: Stanley Septic

Improvement Permit by: RS date 4/16/04 Operation Permit by: RS date 8/31/04

Authorization to Construct by: RS date 4/16/04 Existing System Inspection by: date

HEALTH DEPT. COPY: WHITE OWNER COPY (FINAL): YELLOW OWNER COPY (INITIAL): PINK