2100

IREDELL COUNTY HEALTH DEPARTMENT

STATESVILLE 704-878-5305 MOORESVILLE 704-664-5281

IMPROVEMENT PERMIT / AUTHORIZATION TO CONSTRUCT / OPERATION PERMIT / EXISTING SYSTEM INSPECTION

PERMIT# 71792 PIN# ~~4625944168447 (Tim Helms const)~~ 4635-12-9274 DATE 5/19/00

OWNER OR CONTRACTOR CRESCENT RESOURCES / ~~Crescent Resources~~ PHONE: Business _____ Home _____

ADDRESS PO BOX 1003 CHARLOTTE

LOCATION BRANLEY SCHOOL - TL POINTE DR - QUEEN ANN CIRCLE - TO VINEYARD DR - TO FALMOUTH ON RT

SUBDIVISION POINTE BLOCK / SECTION 1A LOT 87 LOT AREA 44,270ft² SITE CLASS. PS DESIGN FLOW ~~600~~ 600gal. T.A.R. .25gal/ft²

Septic Tank: ~~1500~~ 1500 Gallons; STB 338 Date 7-24-01

Pump Tank: 1500 Gallons; PT 338 Date 6-27-01

Pump Make: Meyers Model Me50 Serial No. _____

Nitrification Field: No Fields 1 Square Feet 1200 Linear Feet 400

No Lines 4@100' Trench Width 36" Max Trench Bottom Depth 36" Gravel Depth N/A

☑ New System ☐ Repair System Type: I, II, III, IV, V, VI

System Description: PUMP PANEL

Repair System Description: LP PANEL

Maintenance Agreement Required: ☑ Yes ☐ No

☑ House/Mod. Home No. Bedrooms ~~4~~ 5

☐ Mobile Home No. Bathrooms 5

☐ Business No. Employees _____

☐ Other _____


☐ Slab ☑ Crawl Space ☐ Basement w/plumbing ☐ Basement wo/plumbing

Water Supply: ☐ Individual ☐ Public ☑ ~~Community~~


Comments:/Conditions:

Comments:/Conditions: Installed Panel lines as drawn Cover a little, shallow, must have 6" when backfilled. Checked Elect, Alarm & Pressure 2/7/03

1"=50' INITIAL SITE SKETCH

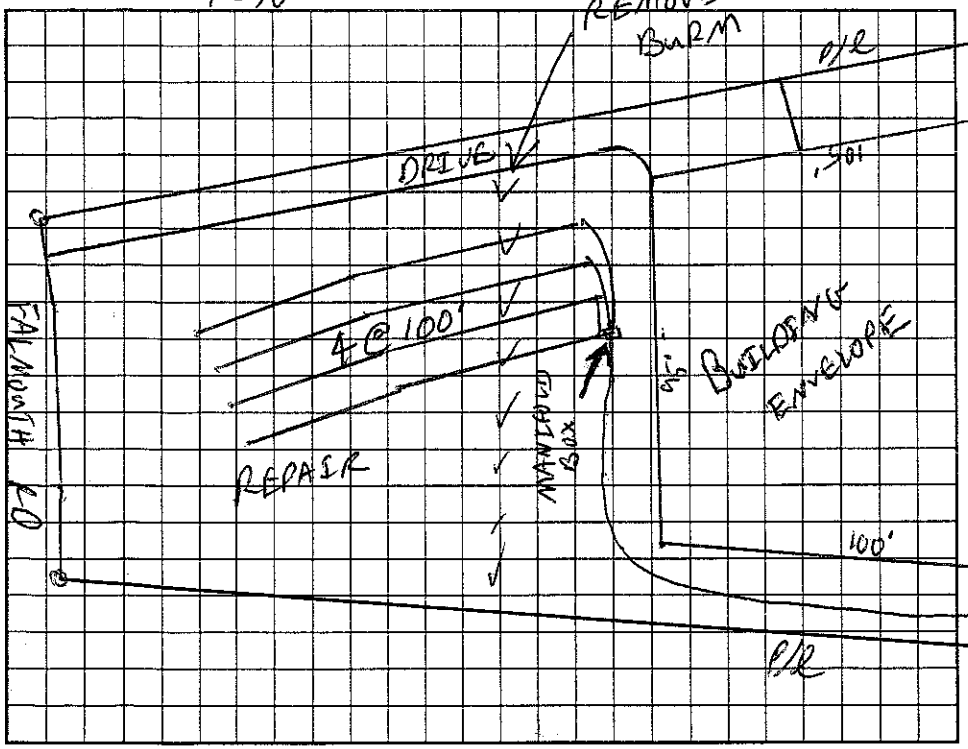

AS BUILT SKETCH

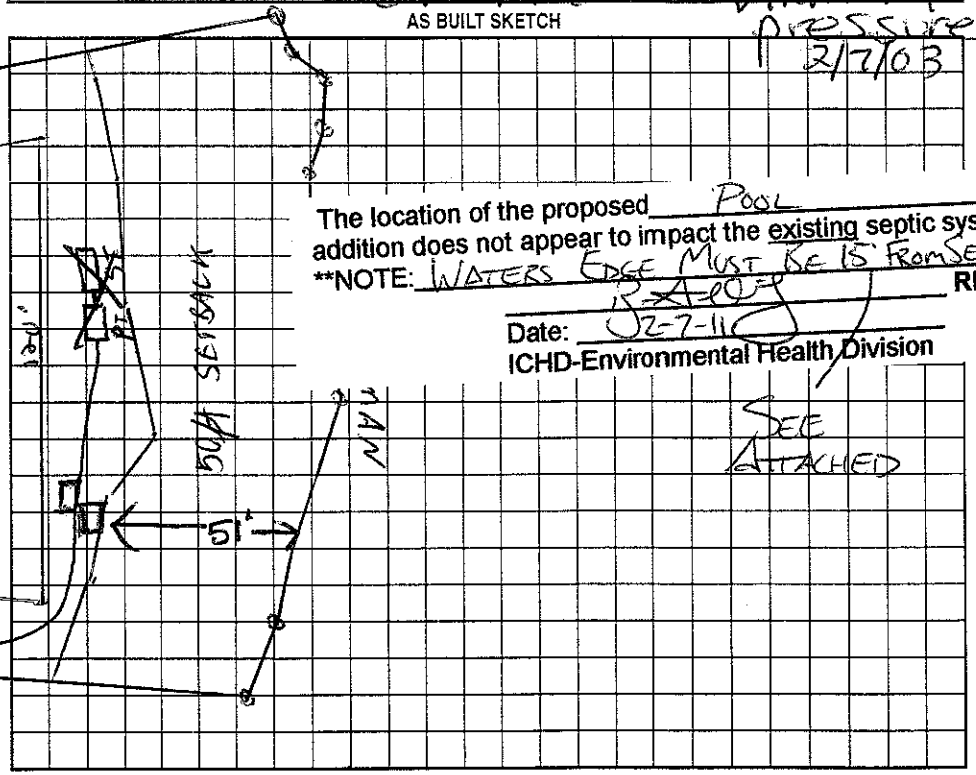

The location of the proposed Pool addition does not appear to impact the existing septic syster
**NOTE: Waters Edge Must Be 15' From Septic
REHS
Date: 12-7-11
ICHD-Environmental Health Division

Permit can be suspended or revoked if any false information is supplied toward securing the permit/any unauthorized changes are made to the site/any unauthorized changes are made in the installation of the system. Improvement Permit with plat valid without expiration. Improvement Permit with site plan valid for sixty months. Authorization to Construct is valid for a period equal to that of Improvement Permit – not to exceed sixty months.

Signed: Carolyn A. Spellenberg date 6-19-00 Installed by: Rott Inc RS

Improvement Permit by: C. Hyatt RS date 5/19/00 Operation Permit by: Maria H. Dotson date 2/7/2003

Authorization to Construct by: C. Hyatt RS date 5/19/00 Existing System Inspection by: _____ date _____

HEALTH DEPT. COPY: WHITE OWNER COPY (FINAL): YELLOW OWNER COPY (INITIAL): PINK