Site Address: 103 Waterhouse Court - Mrsol.

IREDELL COUNTY HEALTH DEPARTMENT

STATESVILLE 704-878-5305 MOORESVILLE 704-664-5281

IMPROVEMENT PERMIT / AUTHORIZATION TO CONSTRUCT / OPERATION PERMIT / EXISTING SYSTEM INSPECTION

PERMIT# ~~14-85~~ 205316 PIN# 4635129538 Alan DATE 3-7-07

OWNER OR APPLICANT John Norman | Ken Connor Simonin PHONE: Business 353-8225 Home 664-1338

ADDRESS 164 Ragsdale Trail Mooresville, NC

LOCATION Brawley School Rd TL The Point Dr Queen Anne Circle to Easton Dr to Old Post to Falmouth Rd to Waterhouse Ct.

SUBDIVISION The Pointe BLOCK / SECTION 1A LOT 30 LOT AREA 40,396 SITE CLASS PS DESIGN FLOW 600gpd L.T.A.R. .25

Septic Tank: 1500 Gallons; STB 444 Date 5-5-5

Pump Tank: _____ Gallons; PT _____ Date _____

Pump Make: _____ Model _____ Serial No. _____

Nitrification Field: No Fields 1 Square Feet 1800 Linear Feet 600 ft

No Lines 5@120' Trench Width 36" Max Trench Bottom Depth 30-36" Gravel Depth N/A

☒ New System ☐ Repair ☐ Expansion System Type: I II III IV V VI

System Description: Gravity - 25% Reduction

Repair System Description: ~~Pump~~ 25-50% Reduction

Maintenance Agreement Required: ☐ Yes ☒ No

☒ House/Mod. Home ☐ Mobile Home ☐ Business ☐ Other

No. Bedrooms 5 (6) No. Persons ____ No. Employees ____

Water Supply: ☐ Individual ☒ Public ☒ Community


☒ Gravity ☐ Pressure ☐ Slab ☒ ~~Crawl Space~~ ☐ Basement w/plumbing ☐ Basement wo/plumbing

Comments/Conditions: Must keep Septic System at least 15ft from any "cut" 2ft or greater


Comments/Conditions: 8/25/14 Reviewed Floor plans in Compliance with IP Septic permit Note: Floor plans have 3 Bedrooms plus Future Guest in Basement

Scale 1:50'

INITIAL SITE SKETCH

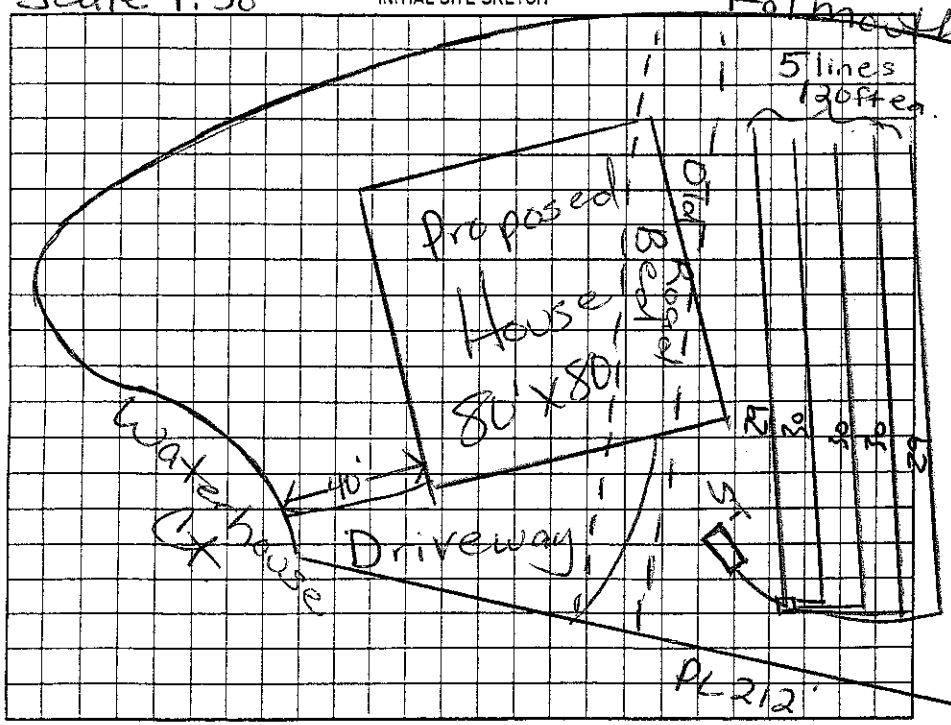

AS BUILT SKETCH

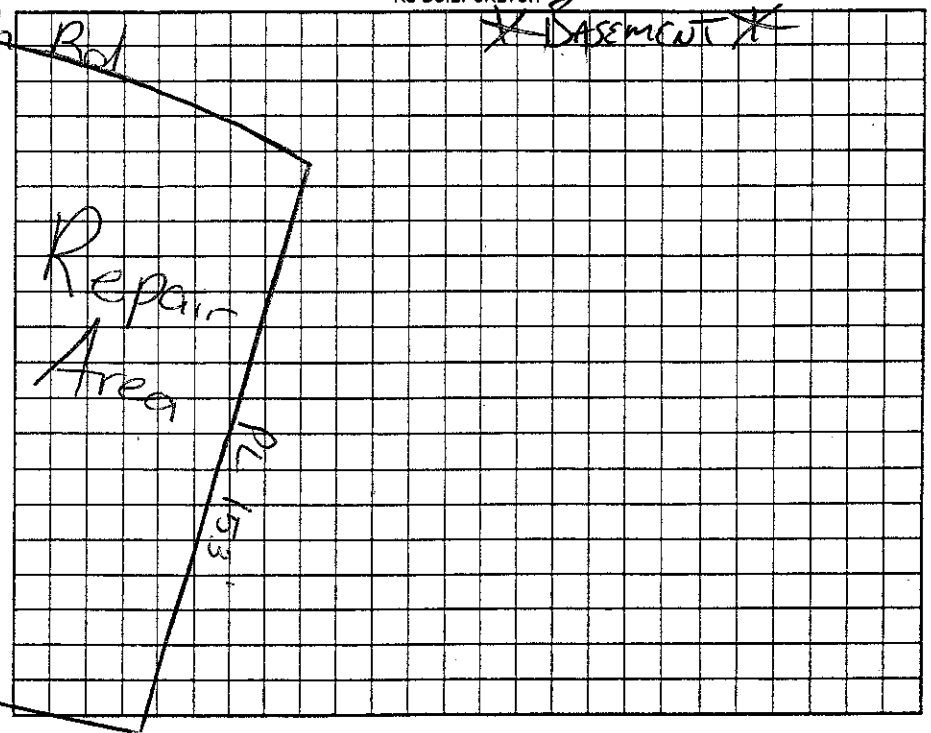

Permit can be suspended or revoked if any false information is supplied toward securing the permit/any unauthorized changes are made to the site/any unauthorized changes are made in the installation of the system. Improvement Permit with plat valid without expiration ☐ Improvement Permit with site plan valid for sixty months ☐ Authorization to Construct is valid for a period equal to that of Improvement Permit – not to exceed sixty months.

Signed: Stu Newell date 3-7-07

Improvement Permit by: Maia Dolan RS date 3/7/07


Authorization to Construct by: Maia Dolan RS date 8/25/14

Installed by: _____

Operation Permit by: R&H APPROVED JUN 04 2008 date _____

Existing System Inspection by: _____ date _____

HEALTH DEPT. COPY: WHITE OWNER COPY (FINAL): YELLOW OWNER COPY (INITIAL): PINK

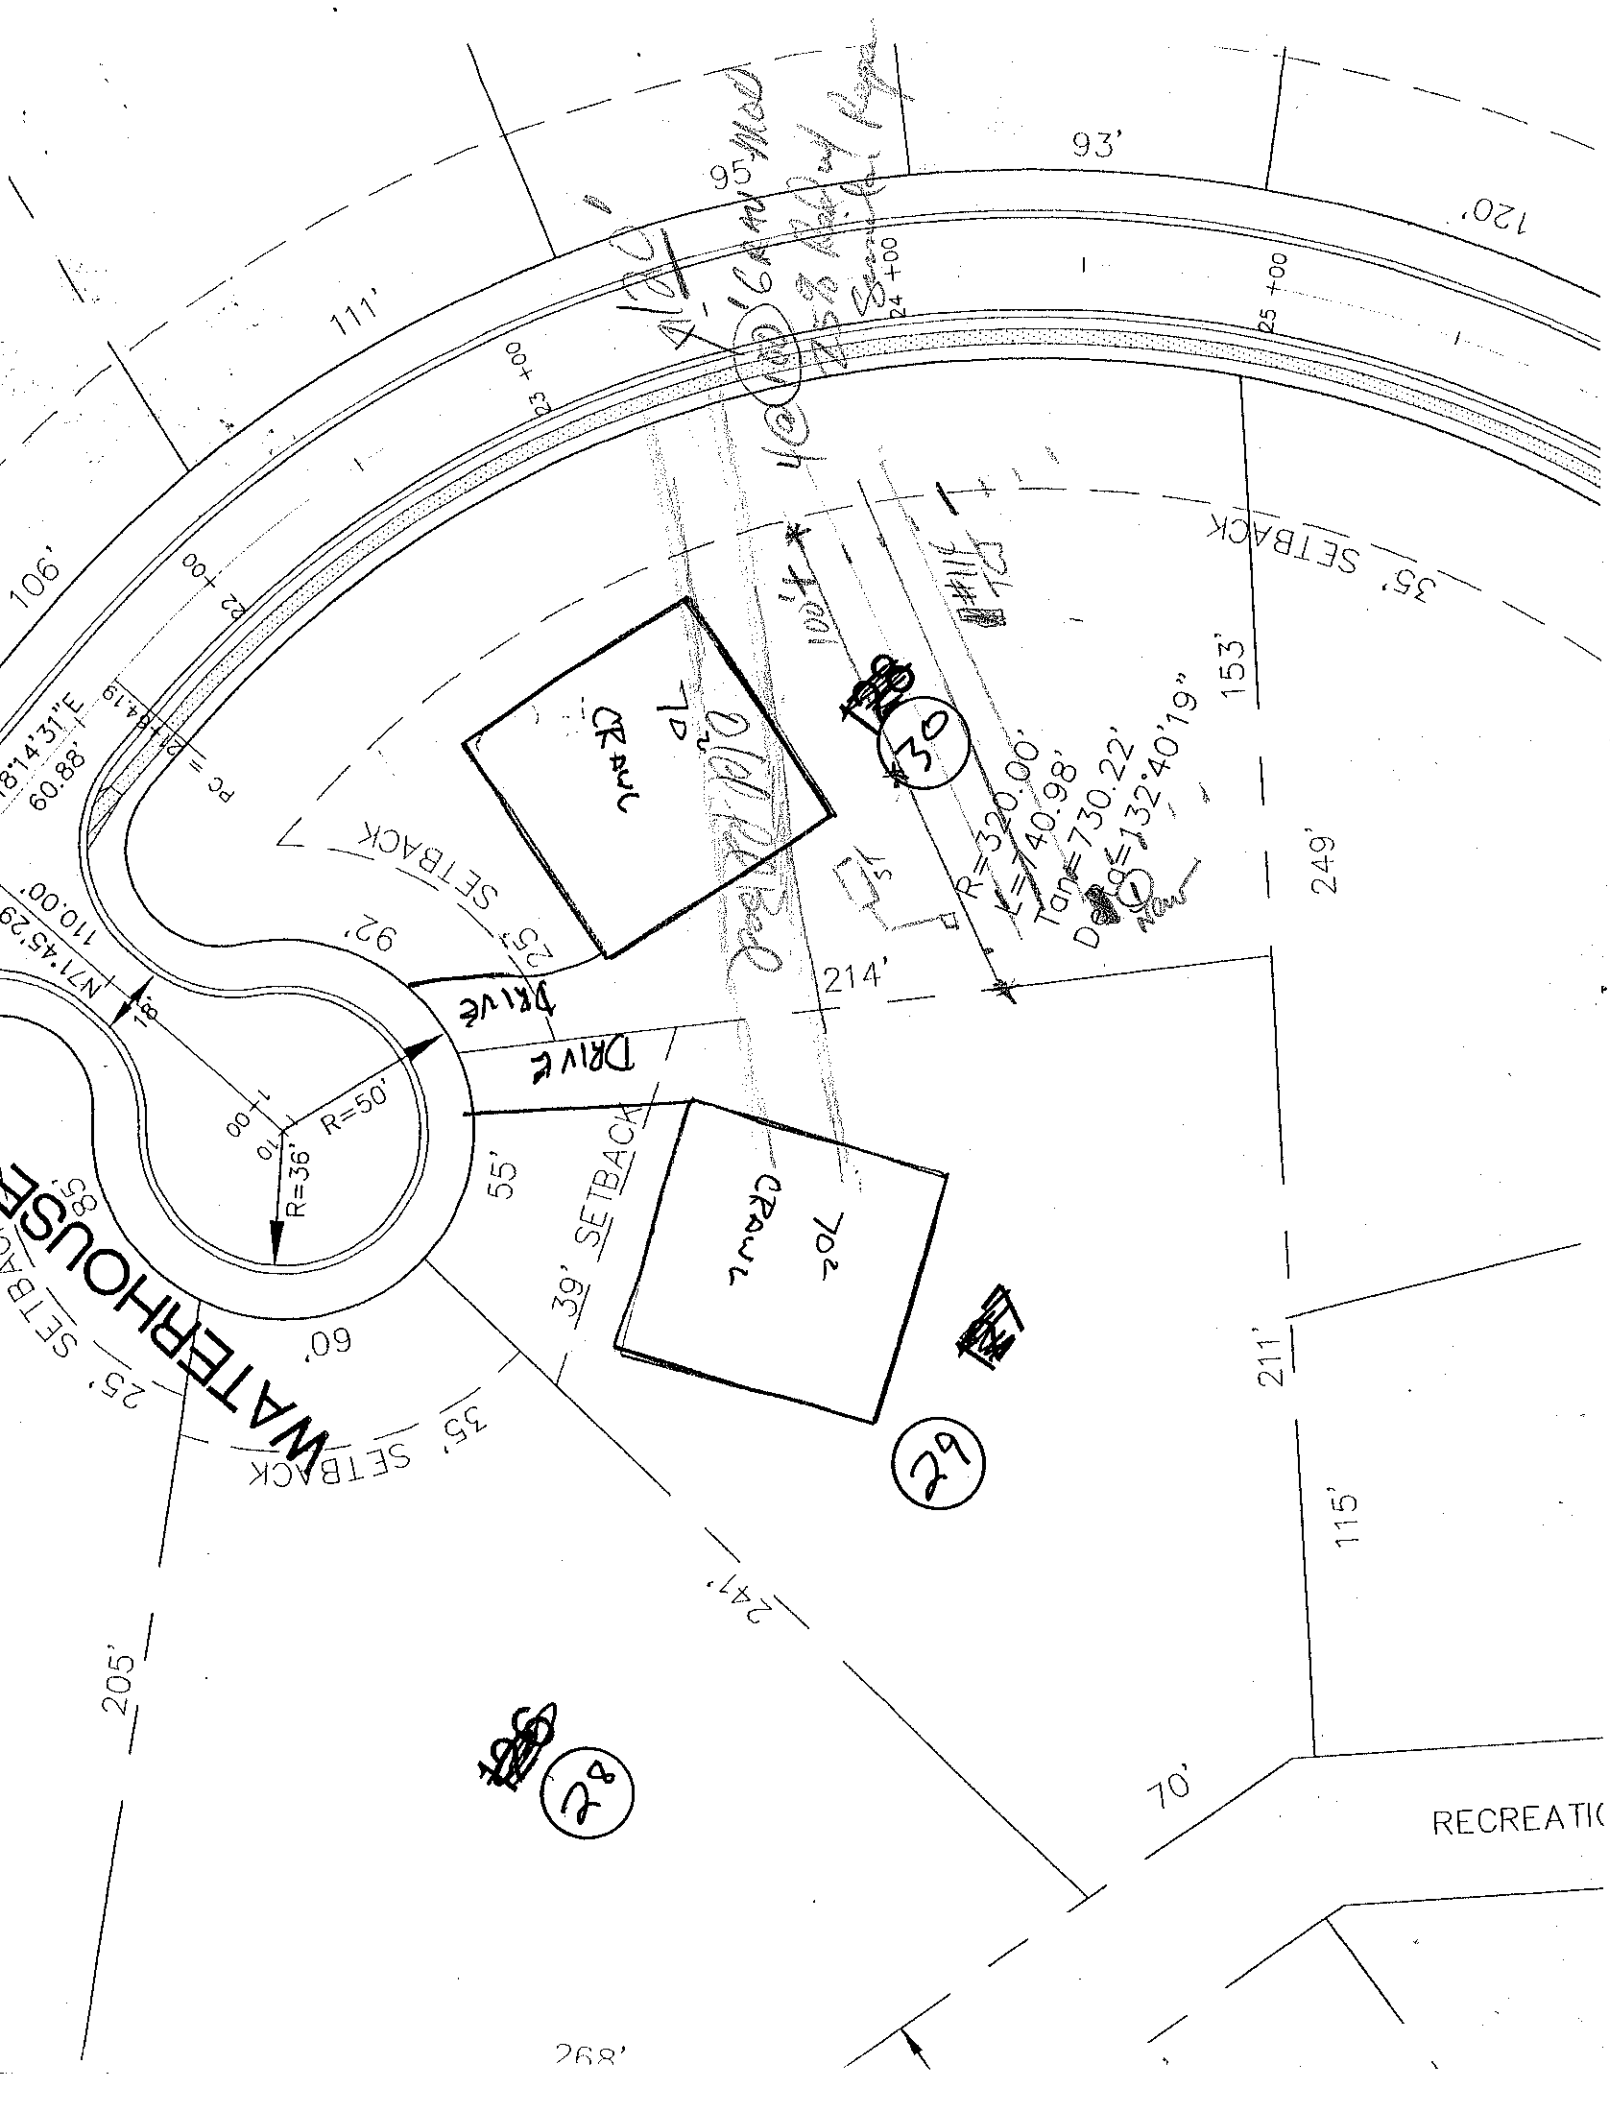
93'
95'
120'
111'
106'
35' SETBACK
153'
249'
214'
211'
115'
247'
205'
268'
70'
55'
39' SETBACK
35' SETBACK
25' SETBACK
92'
110.00'
60.88'
N71°45'29"E
R=320.00'
L=740.98'
Tan=730.22'
Δ=132°40'19"
R=50'
R=36'
DRIVE
DRIVE
WATERHOUSE
RECREATIO
30
29
28