IREDELL COUNTY HEALTH DEPARTMENT

Statesville Office (704) 878-5305 Mooresville Office (704) 660-3625 PERMIT # 181230

IMPROVEMENT PERMIT / AUTHORIZATION TO CONSTRUCT / OPERATION PERMIT / EXISTING SYSTEM

PIN # 4635-12-9814

APPLICANT: MIKE ATHANAS / Bluefield Bldrs APPLICANT ADDRESS: 1999 CANDLEWICK DR.

SITE ADDRESS: 108 WATERHORSE CT. PHONE: 704-576-3887 ALT. PHONE:

SITE DIRECTIONS: BSR, 3RD R IN TRAFFIC CR, TL VINYARD, TL FALMOUTH, TL WATERHORSE

SUBDIVISION: THE POINT SECTION: 1A LOT # 28 LOT AREA: .83 AC DESIGN FLOW: 480 L.T.A.R.: .3

Septic Tank	1500 (gal)	STB	338	Date	9-22-14	☒ New System	☐ Repair	☐ Expansion	System Type: I II (III) IV V VI	☒ Residence	No. Bedrooms 4	Water Supply
Pump Tank	(gal)	PT		Date		System Description:			25% REDUCTION	☐ Business	No. Persons	☐ Private
Pump Make		Model		Serial #		Repair System Description:			LPP PBPS	☐ Other	No. Employees	☐ Public
# Nitrification Fields	1	# Lines	4	Linear Ft:	400'	Maintenance Agreement Required:	☐ YES	☒ NO		☐ Slab	☒ Crawl Space	☒ Community
Trench Width	36"	Max. Trench Bottom Depth	36"	Gravel Depth	—		☒ GRAVITY	☒ PRESSURE		☐ Basement w/ plumbing	☐ Basement w/o plumbing	

Comments / Conditions:

INITIAL SITE SKETCH

SEE PLAN FROM MIKE ATHANAS BA

AS BUILT SKETCH

Permit can be suspended or revoked if any false information is supplied toward securing the permit / any unauthorized changes are made to the site / any unauthorized changes are made in the installation of the system. **CONTACT A LOCATOR SERVICE PRIOR TO ANY EXCAVATION**

~~☒~~ **IMPROVEMENT PERMIT** *with plat valid without expiration.* ☒ **IMPROVEMENT PERMIT** *with site plan valid for 60 mos.* ☐ **AUTHORIZATION TO CONSTRUCT** *valid for period equal to IMPROVEMENT PERMIT--not to exceed 60 mo.*

Owner / Applicant Signature: [signature] Date: 11-12-13 Installed by: ABERNATHY

IMPROVEMENT PERMIT by: BA Date: 10-24-13 OPERATION PERMIT by: BA Date: 11-6-14

AUTHORIZATION TO CONSTRUCT by: [signature] Date: 11-20-13 Existing System Inspected by: Date:

Health Dept. Copy - WHITE Applicant (Final Approval) - YELLOW Applicant (Conditional Approval) - PINK


The Asheville

Plan #: 1219F-L-01-3S

Elevation "D"

Gowos
WE 1012 HW

10-24-13

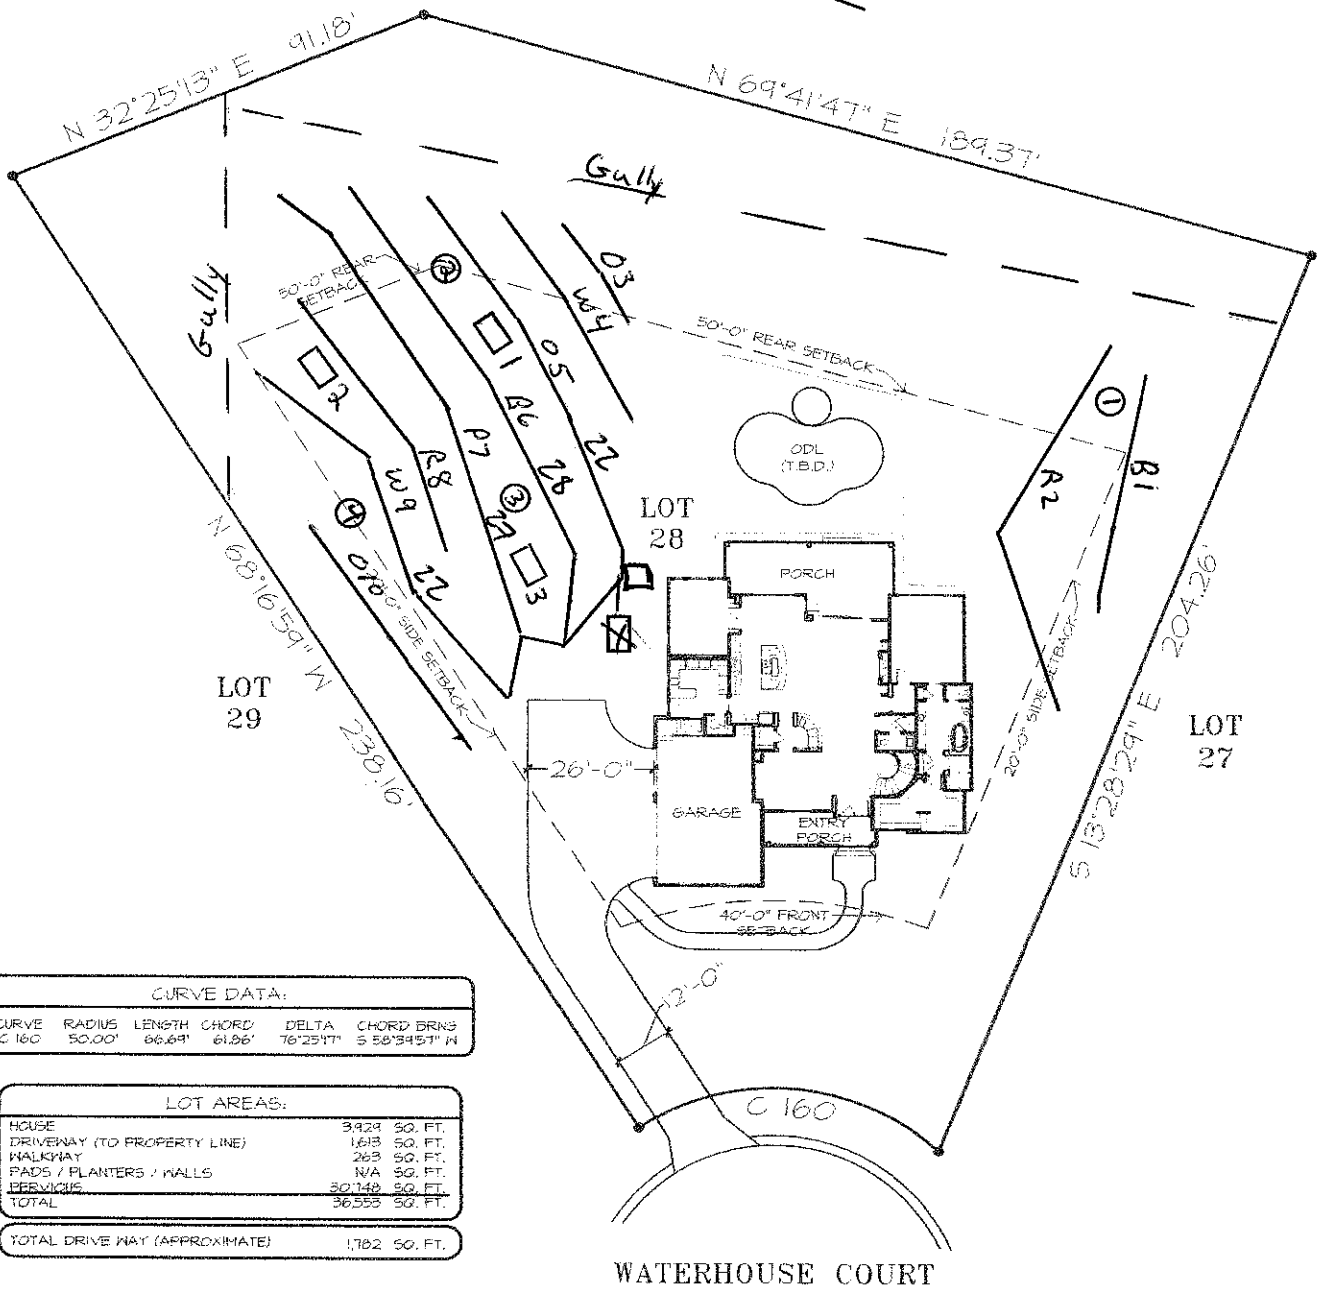

CURVE DATA:					
CURVE	RADIUS	LENGTH	CHORD	DELTA	CHORD BRNG
C 160	50.00'	66.69'	61.86'	76°25'17"	S 58°34'57" W

LOT AREAS:	
HOUSE	3,929 SQ. FT.
DRIVEWAY (TO PROPERTY LINE)	1,618 SQ. FT.
WALKWAY	263 SQ. FT.
PADS / PLANTERS / WALLS	N/A SQ. FT.
PERVIOUS	30,148 SQ. FT.
TOTAL	36,555 SQ. FT.
TOTAL DRIVE WAY (APPROXIMATE)	1,762 SQ. FT.

SCALE: 1" = 40'

A Custom Residence for:

Mr. and Mrs. Laury

Note: Plan information is conceptual only. Certain items may be changed at production stage. Clouded areas modified to accommodate change requests.

Franchise:	*#98 Bluefield Builders, LLC*
File # :	*Laury-C*
Drawn By:	*MDG*
Date:	*September 12, 2013*

Lot28
The Point at Lake Norman

Arthur Rutenberg Homes