IREDELL COUNTY HEALTH DEPARTMENT

ST[illegible]ILLE 704[illegible]5 MOORESVILLE 704-664-5281

IMPROVEMENT PERMIT / AUTHORIZATION TO CONSTRUCT / OPERA[illegible]N PERMIT / EXISTING SYSTEM INSPECTION

PERMIT# 072833 PIN# 4625446864 4635-13-0792 DATE July 27 '98

OWNER OR CONTRACTOR Crescent Resources Inc. PHONE: Business Home

ADDRESS PO Box 1007 Charlotte

LOCATION Brawley Sch. Rd. TL The Pointe Dr. 2820 Queen Anne Circle to Easton Rd to old Post Rd - on Right

SUBDIVISION The Pointe BLOCK / SECTION 1A LOT 18 LOT AREA 29,923 ft² SITE CLASS. PS DESIGN FLOW 460gpd L.T.A.R. .25-.3

Septic Tank: ~~1000~~ 1500 Gallons; STB 797 Date 1/11/99

Pump Tank: 1000 Gallons; PT 27 Date 12/12/98

Pump Make: MYERS Model ME-50 SZL Serial No. 8198

Nitrification Field: No Fields 1 Square Feet 900 Linear Feet 300

No Lines 6@50 Trench Width 36" Max Trench Bottom Depth 30" Gravel Depth NA

☐ New System ☐ Repair System Type: I, II, III, (IV), V, VI

System Description: LP Panel Block

Repair System Description: LP Panel Block

Maintenance Agreement Required: ☑ Yes ☐ No

☑ House/Mod. Home No. Bedrooms 4

☐ Mobile Home No. Bathrooms 4

☐ Business No. Employees

☐ Other

☐ Slab ☑ Crawl Space ☐ Basement w/plumbing ☐ Basement wo/plumbing


Water Supply: ☐ Individual ~~☐ Public~~ ~~☐ Community~~

Comments:/Conditions: Fill old Road Bed AREA where needed. Remove any old Berms / TERRACES. Septic System installer to follow specifications in The Pointe Wastewater Disposal Manual. Property

Comments:/Conditions: Jan 4 '99 - House & Site plan reviewed; Driveway must stay side property line NSF

1" = 50'

INITIAL SITE SKETCH

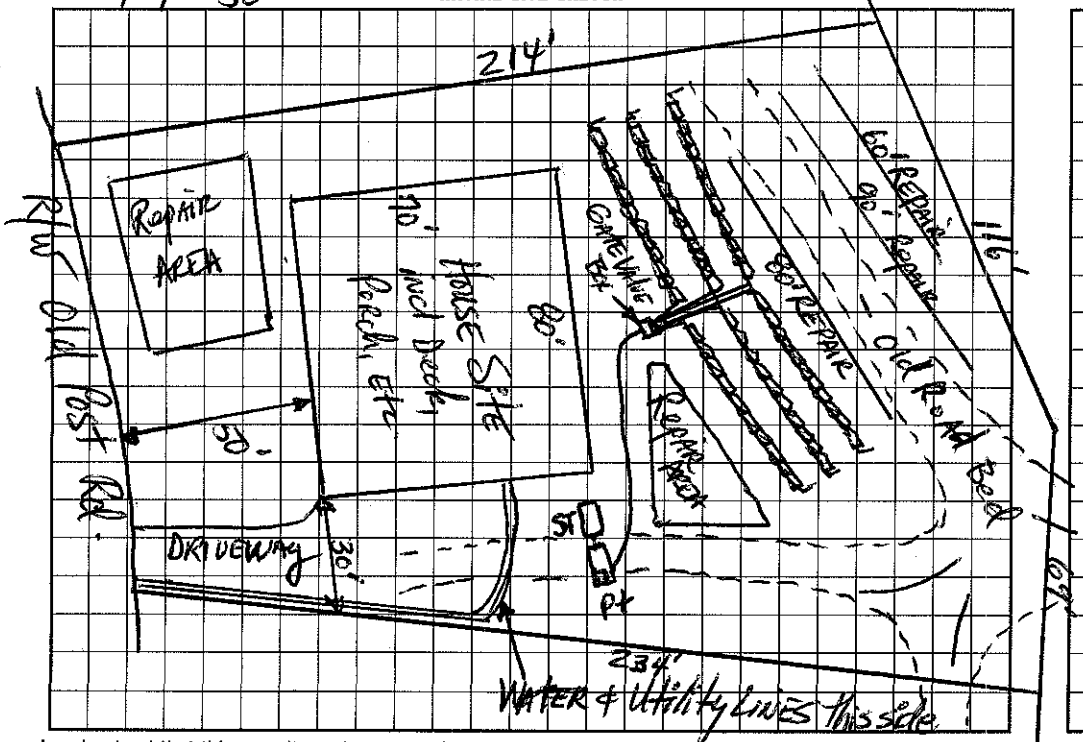

AS BUILT SKETCH

I understand that this permit can be suspended or revoked if any false information is supplied toward securing the permit/any unauthorized changes are made to the site/any unauthorized changes are made in the installation of the system. Improvement Permit with plat valid without expiration. Improvement Permit with site plan valid for sixty months. Authorization to Construct is valid for a period equal to that of Improvement Permit – not to exceed sixty months.

Signed: [signature] date 8-20-98 Installed by: Chris Hedrick - Brad Russell

Improvement Permit by: Mark R Hinson, RS date 7-27-98 Operation Permit by: Wesley Sparks RS date 10/5/99

Authorization to Construct by: Mark R Hinson, RS date 1-4-99 Existing System Inspection by: date

HEALTH DEPT. COPY: WHITE INSPECTION COPY (FINAL): GREEN OWNER COPY (FINAL): YELLOW INSPECTION COPY (INITIAL): PINK OWNER COPY (INITIAL): GOLD