# IREDELL COUNTY HEALTH DEPARTMENT

STATESVILLE 704-878-5305 MOORESVILLE 704-664-5281

## IMPROVEMENT PERMIT / AUTHORIZATION TO CONSTRUCT / OPERATION PERMIT / EXISTING SYSTEM INSPECTION

PERMIT# 072832 PIN# 4625944684 (pt.) 4635 13 0855 DATE July 27 '98

OWNER OR CONTRACTOR Crescent Resources Dlnc // John R. Poore PHONE: Business _____ Home _____

ADDRESS PO Box 1003, Charlotte

LOCATION Brawley Sch. Rd. - R The Pointe Dr. Queen Anne Circle to Eastview Dr. to Old Post Rd. - on Right

SUBDIVISION The Pointe BLOCK / SECTION 1A LOT 17 LOT AREA 31,135 SITE CLASS PS DESIGN FLOW 480 gpd L.T.A.R. .25

Septic Tank: ~~1000~~ 1500 Gallons; STB 338 Date 7/4/99

Pump Tank: 1000 Gallons; PT 27 Date 12/14/99

Pump Make: _____ Model _____ Serial No. _____

Nitrification Field: No Fields 1 Square Feet 1440 Linear Feet 480

No Lines ~~8~~ 12 Trench Width 36" Max Trench Bottom Depth 36"

☑ New System ☐ Repair System Type: I, II, (III) IV, V, VI

System Description: pumped-pm - 25% Reduction

Repair System Description pumped-pm - 25% Reduction

Maintenance Agreement Required: ☐ Yes ☒ No

Gravel Depth NA

☑ House/Mod. Home No. Bedrooms 4

☐ Mobile Home No. Bathrooms 4

☐ Business No. Employees ____

☐ Other _____

☐ Slab ☑ Crawl Space ☐ Basement w/plumbing ☐ Basement wo/plumbing

Water Supply: ☐ Individual ☒ Public ☐ Community


Comments:/Conditions: * ONE inspection/observation port per LATERAL. Remove old Burns/TERRACES. Septic System installer to follow waived specifications in The Pointe Wastewater Proposal Manual.

Comments:/Conditions: 3-15-99 Received house site plan; appears substantially in compliance w/ I.P. SPS

4 @ 120' x 3' Stone Bed

House staked in place —

INITIAL SITE SKETCH 1" = 50'

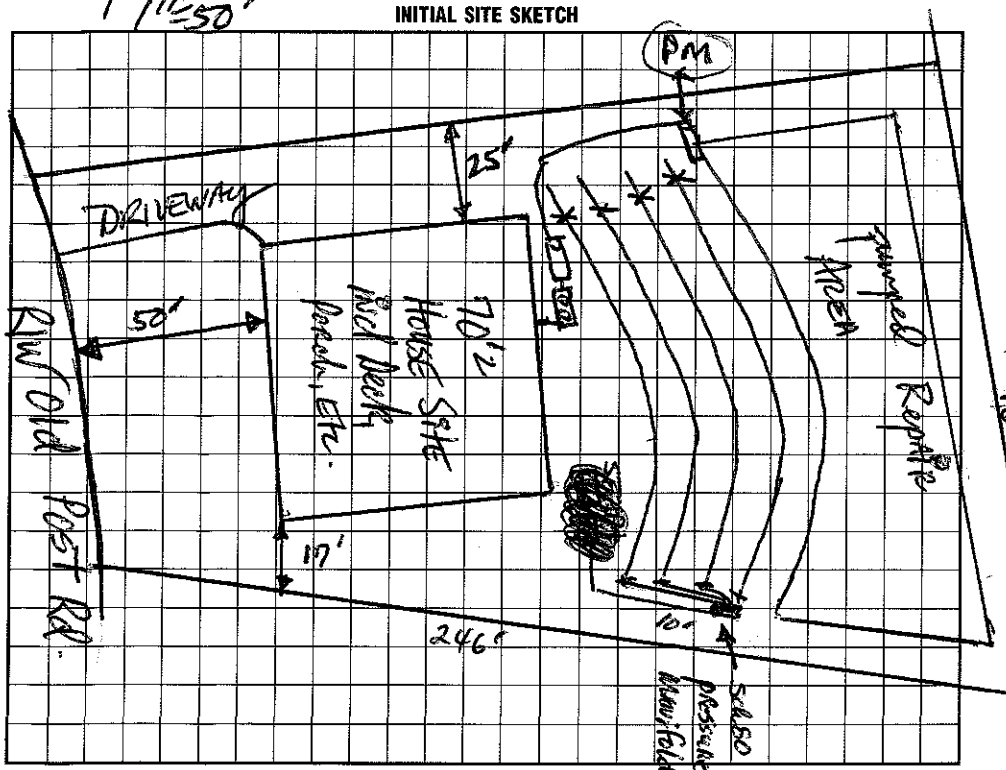


AS BUILT SKETCH

I understand that this permit can be suspended or revoked if any false information is supplied toward securing the permit/any unauthorized changes are made to the site/any unauthorized changes are made in the installation of the system. Improvement Permit with plat valid without expiration. Improvement Permit with site plan valid for sixty months. Authorization to Construct is valid for a period equal to that of Improvement Permit – not to exceed sixty months.

Signed: _____ date 8-20-98 Installed by: Mayhaw Septic Service

Improvement Permit by: Warren Thomas IRS date 7-27-98 Operation Permit by: Wesley Sparks RS. date 5/3/00

Authorization to Construct by: Warren Thomas IRS date 3-15-99 Existing System Inspection by: _____ date _____

HEALTH DEPT. COPY: WHITE INSPECTION COPY (FINAL): GREEN OWNER COPY (FINAL): YELLOW INSPECTION COPY (INITIAL): PINK OWNER COPY (INITIAL): GOLD